

STATE OF KANSAS
STATE CORPORATION COMMISSION


Form CP-4

Give All Information Completely
Make Required Affidavit
Mail or Deliver Report to:
Conservation Division
State Corporation Commission
212 No. Market
Wichita, Kansas 67202

15-051-30395-00-00
WELL PLUGGING RECORD

Ellis County, Sec. 10 Twp. 12 Rge. 18 (E) W (W)

Location as "NE/CNW%SW%" or footage from lines NE SW SE
Lease Owner Dreiling Oil, Inc.
Lease Name Baker Well No. 1
Office Address R.R. # 2 Victoria, Kansas 67671
Character of Well (completed as Oil, Gas or Dry Hole) Dry
Date well completed 2-2 1972
Application for plugging filed 2-2 1972
Application for plugging approved 2-2 1972
Plugging commenced 2-2 1972
Plugging completed 2-2 1972
Reason for abandonment of well or producing formation Dry

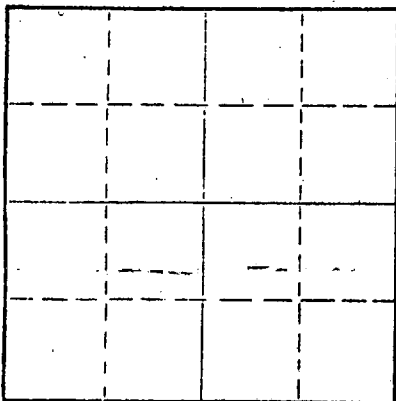

Locate well correctly on above
Section Plat

If a producing well is abandoned, date of last production September 9 1971
Was permission obtained from the Conservation Division or its agents before plugging was commenced? yes

Name of Conservation Agent who supervised plugging of this well Leo Massey Hays, Kansas 67601
Producing formation _____ Depth to top _____ Bottom _____ Total Depth of Well 3,700 Feet
Show depth and thickness of all water, oil and gas formations.

OIL, GAS OR WATER RECORDS

CASING RECORD

FORMATION	CONTENT	FROM	TO	SIZE	PUT IN	PULLED OUT
Surface	Surface Pipe	0	130	8 5/8"	130'	0
Casing	casing	0	3696'	5 1/2"	3696'	2250'

Describe in detail the manner in which the well was plugged, indicating where the mud fluid was placed and the method or methods used in introducing it into the hole. If cement or other plugs were used, state the character of same and depth placed, from _____ feet to _____ feet for each plug set.

Plugged with 3 sacks hulls, 20 sacks gel, 70 sacks cement, 50 - 50 Pozmix, 6% gel, 5 gel, 70 sacks cement 50 - 50 Pozmix 6% gel, 200# input, 100# shut in.

RECEIVED
STATE CORPORATION COMMISSION
2-18-1972
FEB 18 1972
CONSERVATION DIVISION
Wichita, Kansas


(If additional description is necessary, use BACK of this sheet)
Name of Plugging Contractor Dreiling Oil, Inc.
Address Victoria, Kansas 67671

STATE OF Kansas, COUNTY OF Ellis, ss.
I, Leo F. Dreiling, Pres. of Drlg. Contrc. (employee of owner or (owner or operator) of the above-described well, being first duly sworn on oath, says: That I have knowledge of the facts, statements, and matters herein contained and the log of the above-described well as filed and that the same are true and correct. So help me God.

(Signature) Leo F. Dreiling
LEO F. DREILING, R.R. # 2 Victoria, Kansas 67671
(Address)

SUBSCRIBED AND SWORN to before me this 17 day of February, 1972

My commission expires September 19, 1974
Joseph A. Hess
JOSEPH A. HESS Notary Public.

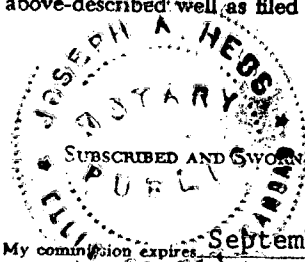

15-051-30395-00-00

L. J. DREILING and SONS, Inc.

VICTORIA, KANSAS

WELL LOG

Company Leo J. Dreiling Oil Co.
Victoria, Kansas

Sec. 10 Twp. 12 Rng. 18

Farm Baker No. 1

Location NE-SW-SE

Total Depth

County Ellis

Comm. 10-4-66

Comp. 10-11-66

Elevation: 2174 K.B.
2171 D. F.

Contractor L. J. Dreiling & Son, Inc.

2169 G. R.

Casing Record

Cement Record

Production:

130' 85/8"
3696' 5 1/2"

100 sack
75 sack s. cement

Arbuckle

STATE OF KANSAS
FEB 9 1972
CONSERVATION DIVISION
Victoria, Kansas

Figures Indicate Bottom of Formations


0'	40'	Surface Soil	Post Rock
40'	85'	Gravel & Sand	
85'	130'	Shale	
130'	750'	Shale & Shells	
750'	875'	Sand	
875'	940'	Shale & Shells	
940'	1095'	Sand	
1095'	1170'	Shale & Shells	
1170'	1425'	Shale & Red bed	
1425'	1472'	Anhy.	
1472'	1770'	Shale & Shells	
1770'	2136'	Shale & Lime	
2136'	2380'	Shale & Lime	
2380'	2605'	Shale & Lime	
2605'	2814'	Shale & Lime	
2814'	2950'	Shale & Lime	
2950'	3210'	Shale & Lime	
3210'	3313'	Lime & Shale	
3313'	3405'	Lime & Shale	
3405'	3470'	Lime	
3470'	3501'	Lime	
3501'	3530'	Lime	
3530'	3591'	Lime	
3591'	3648'	Lime	
3648'	3695'	Lime	
3695'	3700'	Arb.	

STATE OF KANSAS)
)ss
COUNTY OF ELLIS)

I, Leo F. Dreiling, of the L. J. Dreiling & Sons, Inc. upon oath states that the above and foregoing is a true and correct copy from the Daily Drilling Report from your Baker.

Leo F. Dreiling
Leo F. Dreiling

Subscribed and sworn to before me this 11th day of October, 1966.

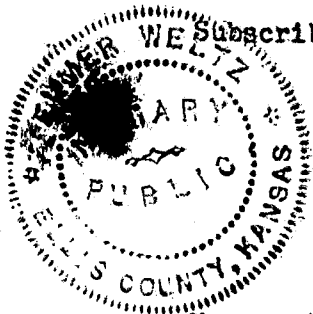

Elmer Weltz
NOTARY PUBLIC

My commission expires: October 26, 1968