

STATE OF KANSAS  
STATE CORPORATION COMMISSION

15-051-00627-00-00  
WELL PLUGGING RECORD

Give All Information Completely  
Make Required Affidavit  
Mail or Deliver Report to:  
Conservation Division  
State Corporation Commission  
800 Bittling Building  
Wichita, Kansas

Ellis County, Sec. 10 Twp. 12S Rge. (E) 18 (W)

Location as "NE/CNW $\frac{1}{4}$ SW $\frac{1}{4}$ " or footage from lines SW $\frac{1}{4}$  SW $\frac{1}{4}$  NE $\frac{1}{4}$

Lease Owner Isern Drilling Co., et al

Lease Name Baker Well No. 1

Office Address Box 92, Ellinwood, Kansas

Character of Well (completed as Oil, Gas or Dry Hole) Dry Hole

Date well completed 6-23-51 19

Application for plugging filed 6-23-51 19

Application for plugging approved 6-23-51 19


Plugging commenced 6-23-51 19

Plugging completed 6-23-51 19

Reason for abandonment of well or producing formation Dry Hole

If a producing well is abandoned, date of last production 19

Was permission obtained from the Conservation Division or its agents before plugging was commenced? Yes

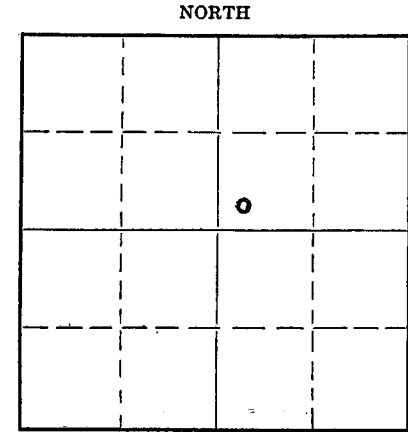

Locate well correctly on above Section Plat

Name of Conservation Agent who supervised plugging of this well Eldon Petty

Producing formation Depth to top Bottom Total Depth of Well 3846 Feet

Show depth and thickness of all water, oil and gas formations.

OIL, GAS OR WATER RECORDS

CASING RECORD

Formation	Content	From	To	Size	Put In	Pulled Out
Surface Pipe		0	170'	8-5/8"	170'	None

Describe in detail the manner in which the well was plugged, indicating where the mud fluid was placed and the method or methods used in introducing it into the hole. If cement or other plugs were used, state the character of same and depth placed, from feet to feet for each plug set.

Mudded hole with heavy mud to 165'. Set rock bridge and cemented with fifteen sacks cement. Mudded to 40'. Bridged and cemented with ten sacks, cement returning to base of cellar.

RECEIVED  
STATE CORPORATION COMMISSION  
6-28-1951  
JUN 28 1951  
CONSERVATION DIVISION  
Wichita, Kansas

(If additional description is necessary, use BACK of this sheet)

Correspondence regarding this well should be addressed to G. W. Keyes Drilling Co.  
Address Box 92, Ellinwood, Kansas

STATE OF KANSAS, COUNTY OF BARTON, ss.

I, Edw. H. Isern, Part Owner (employee of owner or owner or operator) of the above-described well, being first duly sworn on oath, says: That I have knowledge of the facts, statements, and matters herein contained and the log of the above-described well as filed and that the same are true and correct. So help me God.

(Signature) Edw. H. Isern

Ellinwood, Kansas  
(Address)

SUBSCRIBED AND SWORN to before me this 27th day of June, 19 51

My commission expires Feb. 10, 1955.

George Meyer  
Notary Public.

22-7377-8 4-49-10M

PLUGGING  
FILE SEC-10 TLY R112  
BOOK PAGE 99 LINE 88



WELL LOG

et al

ISERN DRILLING COMPANY, OWNER - Baker #1.  
SW $\frac{1}{4}$  SW $\frac{1}{4}$  NE $\frac{1}{4}$  Section 10, Township 12S, Range 18W.  
Ellis County, Kansas

Elevation: 2183' DF

Figures indicate bottom of formation

Pipe Record:

8-5/8" set @ 170'

Tops corrected 2' to derrick floor

Topeka 3174'  
Heebner 3406'  
Base Oread 3444'  
Lansing 3453'  
Base K. C. 3689'  
Arbuckle 3728'

0 to 85 clay  
575 shale and shells  
590 sand  
675 shale and shells  
798 sand  
835 shale and shells  
875 sand  
940 shale and shells  
1115 sand  
1310 shale and shells  
1350 shale and sand  
1448 shale and shells  
1483 anhydrite  
1840 shale and shells  
1960 salt  
2055 shale and shells  
2585 lime and shale  
2690 shale and lime  
2720 shale and shells  
3150 shale and lime  
3220 lime and shale  
3409 lime  
3414 Heebner  
3730 lime  
3746 arbuckle  
3746 Total Depth - D & A

Rotary commenced 6-13-51  
completed 6-23-51

STATE OF KANSAS )  
COUNTY OF BARTON ) SS

I, Edw. H. Isern, Part Owner of the above-described well, being first duly sworn on oath, declare: That I have knowledge of the facts, statements and matters herein contained pertaining to the log of the above-described well as filed, and that the same are true and correct.

*Edw H Isern*

Subscribed and Sworn to before me this 27th day of June, 1951.

*George A Meyer*  
Notary Public

My commission expires Feb. 10, 1955.

6-28-1951  
PLUGGING  
FILE SEC 10 T 12R 18W  
BOOK PAGE 90 LINE 28