


STATE OF KANSAS
STATE CORPORATION COMMISSION
Give All Information Completely
Make Required Affidavit
Mail or Deliver Report to:
Conservation Division
State Corporation Commission
800 Bitting Building
Wichita, Kansas

WELL PLUGGING RECORD

NORTH

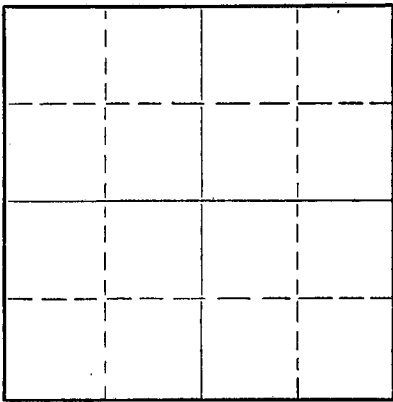

Locate well correctly on above
Section Plat

Ellis County. Sec. 29 Twp. 12 Rge. 20 (E) (W)
Location as "NE/CNW/SW" or footage from lines NW NW NW
Lease Owner Musgrove Petroleum Corporation
Lease Name Zanella Well No. 1
Office Address 518 Petroleum Building, Wichita, Kansas
Character of Well (completed as Oil, Gas or Dry Hole) Dry Hole
Date well completed December 31, 19 52
Application for plugging filed December 31, 19 52
Application for plugging approved 19
Plugging commenced December 31, 19 52
Plugging completed December 31, 19 52
Reason for abandonment of well or producing formation Dry

If a producing well is abandoned, date of last production 19
Was permission obtained from the Conservation Division or its agents before plugging was commenced?

Name of Conservation Agent who supervised plugging of this well
Producing formation Depth to top Bottom Total Depth of Well 3960 Feet
Show depth and thickness of all water, oil and gas formations.

OIL, GAS OR WATER RECORDS

CASING RECORD

FORMATION	CONTENT	FROM	TO	SIZE	PUT IN	PULLED OUT
				8 5/8	276'	

Describe in detail the manner in which the well was plugged, indicating where the mud fluid was placed and the method or methods used in introducing it into the hole. If cement or other plugs were used, state the character of same and depth placed, from feet to feet for each plug set.

Set first plug at 250' with 15 sacks of cement
second plug at 35' with 1/2 sacks of hulls and 10
sacks of cement.

RECEIVED
STATE CORPORATION COMMISSION
1-2-1953
JAN 2 - 1953

CONSERVATION DIVISION
Wichita, Kansas

(If additional description is necessary, use BACK of this sheet)
Name of Plugging Contractor Musgrove Petroleum Corporation
Address 518 Petroleum Building, Wichita, Kansas

STATE OF Kansas, COUNTY OF Sedgwick, ss.
Gordon L. Koelling (employee of owner) or (owner or operator) of the above-described well, being first duly sworn on oath, says: That I have knowledge of the facts, statements, and matters herein contained and the log of the above-described well as filed and that the same are true and correct. So help me God.

(Signature) Gordon L. Koelling
518 Petroleum Building, Wichita, Kansas
(Address)

SUBSCRIBED AND SWORN to before me this 31st day of December, 19 52
My commission expires November 14, 1956.

Mary L. Luman
Notary Public.

PLUGGING
FILE SEC 29 T 12 R 20
BOOK PAGE 70 LINE 10

CONTRACTOR'S WELL LOG

COMPANY: Musgrove Petroleum Corporation
 CONTRACTOR: Musgrove Petroleum Corporation
 FARM: Zanella #1
 LOCATION: NW NW NW Section 29-12-20
 Ellis County, Kansas
 COMMENCED: December 12, 1952
 COMPLETED: December 31, 1952

0	140	Surface soil and shale
140	170	Blue shale
170	370	Shale
370	700	Blue shale
700	790	Grey shale
790	1145	Blue shale
1145	1200	Shale and sand
1200	1470	Shale and shells
1470	1580	Red bed
1580	1630	Anhydrite
1630	1900	Shale
1900	2235	Shale and shells
2235	2865	Lime and shale
2865	2910	Shale and shells
2910	3771	Lime and shale
3771	3823	Lime
3823	3877	Lime and shale
3877	3880	Lime
3880	3960	Lime and shale
	3960	Rotary total depth

Set 276' of 8 5/8" with 170 sacks of cement.

Dry and abandoned.


STATE OF KANSAS)
)
 COUNTY OF SEDGWICK)

SS

RECEIVED
 STATE CORPORATION COMMISSION
 1-2-1953
 JAN 2 - 1953

I, GORDON L. KOELLING do hereby certify that the above and foregoing
 is a true and correct copy of the log of the Zanella #1, Section 29-12-20
 Ellis County, Kansas as reflected by the files of the Musgrove Petroleum
 Corporation.

MUSGROVE PETROLEUM CORPORATION

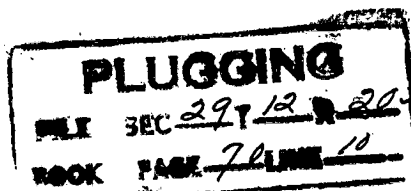

By

Gordon L. Koelling
 Secretary-Treasurer

Subscribed and sworn to before me a Notary Public in and for Sedgwick County, Kansas, this 31st day of December, 1952.

Mary L. Dunn
 Notary Public

My Commission Expires: November 14, 1956.