


STATE OF KANSAS
STATE CORPORATION COMMISSION

WELL PLUGGING RECORD

Give All Information Completely
Make Required Affidavit
Mail or Deliver Report to:
Conservation Division
State Corporation Commission
212 North Market, Insurance Bldg.
Wichita, Kansas

Ellis County, Sec. 33 Twp. 12S Rge. 20 (E) W (W)
SW NW SW

NORTH

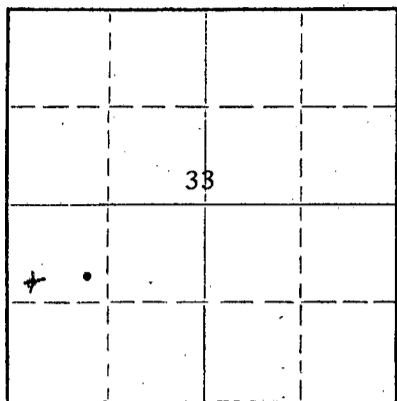

Locate well correctly on above
Section Plat

Location as "NE/CNW&SW" or footage from lines _____
Lease Owner Nadel and Gussman
Lease Name Erbert Well No. 1
Office Address _____
Character of Well (completed as Oil, Gas or Dry Hole) Dry hole
Date well completed June 12 19 60
Application for plugging filed June 12 19 60
Application for plugging approved June 12 19 60
Plugging commenced June 12 19 60
Plugging completed June 12 19 60
Reason for abandonment of well or producing formation _____

If a producing well is abandoned, date of last production _____ 19 _____
Was permission obtained from the Conservation Division or its agents before plugging was commenced? Yes

Name of Conservation Agent who supervised plugging of this well Loren Petty
Producing formation _____ Depth to top _____ Bottom _____ Total Depth of Well 3,870 Feet
Show depth and thickness of all water, oil and gas formations.

OIL, GAS OR WATER RECORDS

CASING RECORD

FORMATION	CONTENT	FROM	TO	SIZE	PUT IN	PULLED OUT

Describe in detail the manner in which the well was plugged, indicating where the mud fluid was placed and the method or methods used in introducing it into the hole. If cement or other plugs were used, state the character of same and depth placed, from _____ feet to _____ feet for each plug set.

Filled hole with heavy mud to 600' and cemented with 20 sacks of cement. Filled hole with heavy mud to 180' and cemented with 20 sacks of cement, filled hole with heavy mud to 40' and cemented with 10 sacks of cement to top.

RECEIVED
STATE CORPORATION COMMISSION
7-5-1960
JUL 5 1960
CONSERVATION DIVISION
Wichita, Kansas

(If additional description is necessary, use BACK of this sheet)
Name of Plugging Contractor Jones Drilling Company
Address Great Bend, Kansas

STATE OF Kansas, COUNTY OF Barton, ss.
A. M. Jones (employee of owner) or (owner or operator) of the above-described well, being first duly sworn on oath, says: That I have knowledge of the facts, statements, and matters herein contained and the log of the above-described well as filed and that the same are true and correct. So help me God.

(Signature) A. M. Jones
P. O. Box 106, Great Bend, Kansas
(Address)

SUBSCRIBED AND SWORN TO before me this 28th day of June, 19 60

My commission expires April 11, 1963
John W. Poos Notary Public.

WELL LOG

Date started 5-30-60
Date Completed 6-12-60

Erbert #1
SW NW SW
Sec. 33-12S-20W
Ellis County, Kansas

0' - 200' Shale and shell
200' - 990' Shale
990' - 1230' Sand
1230' - 1450' Shale and redbed
1450' - 1530' Lime and shale
1530' - 1565' Anhydrite
1565' - 2100' Shale and shell
2100' - 3365' Lime and shale
3365' - 3405' Lime
3405' - 3455' Lime and shale
3455' - 3507' Lime
3507' - 3550' Lime and shale
3550' - 3725' Lime
3725' - 3772' Lime and shale
3772' - 3815' Lime
3815' - 3841' Sand, shale and lime
3841' - 3870' Lime

RECEIVED
STATE COMMISSION
7-5-1960
JUL 5 1960
CONSERVATION DIVISION
Wichita, Kansas

AFFIDAVIT

State of Kansas County of Barton

I, A. M. Jones, certify that the above is a true and correct log as reflected by the Daily Drilling Reports of the Jones Drilling Company.

By: *A. M. Jones*
A. M. Jones Owner

Subscribed and sworn before me this 28th day of June, 1960.

John W. Poos
Notary Public - John W. Poos

My commission expires April 11, 1963