


STATE OF KANSAS
STATE CORPORATION COMMISSION

WELL PLUGGING RECORD

Give All Information Completely
Make Required Affidavit
Mail or Deliver Report to:
Conservation Division
State Corporation Commission
211 No. Broadway
Wichita, Kansas

NORTH

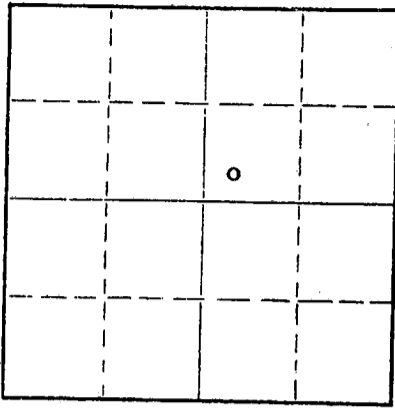

Locate well correctly on above
Section Plat

m Ellis County. Sec. 36 Twp. 12S Rge. 20W (E) (W)
Location as "NE/CNW&SW" or footage from lines SW NW NE
Lease Owner Winwell 1968 Exploration Co.
Lease Name Schwagel "A" Well No. 1
Office Address 1011 Commercial Nat'l Bank Bldg., Shreveport, La. 71101
Character of Well (completed as Oil, Gas or Dry Hole) Dry Hole
Date well completed November 12 19 68
Application for plugging filed November 12 19 68
Application for plugging approved November 12 19 68
Plugging commenced November 12 19 68
Plugging completed November 12 19 68
Reason for abandonment of well or producing formation Dry Hole

If a producing well is abandoned, date of last production _____ 19____
Was permission obtained from the Conservation Division or its agents before plugging was commenced? _____

Name of Conservation Agent who supervised plugging of this well Eldon Petty, Hays, Kansas
Producing formation _____ Depth to top _____ Bottom _____ Total Depth of Well 3495 Feet
Show depth and thickness of all water, oil and gas formations.

OIL, GAS OR WATER RECORDS

CASING RECORD

FORMATION	CONTENT	FROM	TO	SIZE	PUT IN	PULLED OUT
Surface Casing		0	214'	8 5/8"	214'	None

Describe in detail the manner in which the well was plugged, indicating where the mud fluid was placed and the method or methods used in introducing it into the hole. If cement or other plugs were used, state the character of same and depth placed, from _____ feet to _____ feet for each plug set.

Plug: 800'/70 sacks cement
240'/20 sacks cement
40'/10 sacks cement

RECEIVED
STATE CORPORATION COMMISSION
NOV 21 1968
CONSERVATION DIVISION
Wichita, Kansas

(If additional description is necessary, use BACK of this sheet)
Name of Plugging Contractor Hellar Drilling Company, Inc.
Address 339 Union Center, Wichita, Kansas 67202

STATE OF Kansas COUNTY OF Sedgwick, ss. D. L. Hellar, Pres., Hellar Drlg. Co. Inc. (employee of owner) or (owner or operator) of the above-described


well, being first duly sworn on oath, says: That I have knowledge of the facts, statements, and matters herein contained and the log of the above-described well as filed and that the same are true and correct. So help me God.

(Signature) D. L. Hellar Pres., Hellar Drilling Co., Inc.
339 Union Center, Wichita, Kansas 67202
(Address)

SUBSCRIBED AND SWORN to before me this 18th day of November, 19 68

My commission expires March 25, 1972

Catherine Darcey
Catherine Darcey
Notary Public.

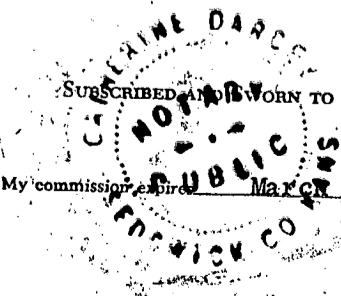

DRILLER'S LOG

COMPANY: Winwell 1968 Exploration Co., Shreveport, La.
 CONTRACTOR: Hellar Drilling Company, Inc., Wichita, Kansas
 LEASE: #1 Schwagel "A"
 LOCATION: SW NW NE Sec. 36-12S-20W, Ellis County, Kansas
 COMMENCED: November 7, 1968
 COMPLETED: November 12, 1968
 CASING: Set 8 5/8" Surface Casing @ 214'/160 sacks cement

0-1390	Shale
1390-1695	Shale & Lime
1695-2070	Shale & Shells
2070-2350	Lime & Shale
2350-2545	Lime
2545-3400	Lime & Shale
3400-3495	Lime
3495	Rotary Total Depth

D & A

RECEIVED
 STATE CORPORATION COMMISSION
 NOV 21 1968
 CONSERVATION DIVISION
 Wichita, Kansas

STATE OF KANSAS)
) SS
 COUNTY OF SEDGWICK)

I, D. L. Hellar, do hereby certify that the above and foregoing is a true and correct copy of the log of the #1 Schwagel "A", located in SW NW NE Section 36-12S-20W, Ellis County, Kansas, as reflected by the files of the Hellar Drilling Company, Inc.

HELLAR DRILLING COMPANY, INC.

By *D. L. Hellar*
 D. L. Hellar, President

Subscribed and sworn to before me, a Notary Public, in and for Sedgwick County, Kansas, this 18th day of November, 1968.

Catherine Darcey
 Catherine Darcey, Notary Public



My Commission Expires : March 25, 1972