

Give All Information Completely
Make Required Affidavit
Mall or Deliver Report to:
Conservation Division
State Corporation Commission
800 Bittling Building
Wichita, Kansas

OR

FORMATION PLUGGING RECORD

Strike out upper line
when reporting plug-
ging off formations.

E. Ellis County, Sec. *36* Twp. *12* Rge. *20* (E) W. (W)

Location as "NE 1/4 NW 1/4 SW 1/4" or footage from lines *NW/ NW/ NW*

Lease Owner *Flynn Oil Co.*

Lease Name *Weigman*

Office Address *809 Thompson Bldg Tulsa Okla* Well No. *1*

Character of Well (completed as Oil, Gas or Dry Hole) *Oil*

Date well completed *4/14* 19*52*

Application for plugging filed *E. Eldon Petty* *12/15* 19*52*

Application for plugging approved *approved* *12/15* 19*52*


Plugging commenced *2/12/52* 19*52*

Plugging completed *12/12* 19*52*

Reason for abandonment of well or producing formation *Went to water*

If a producing well is abandoned, date of last production *9-2* 19*52*

Was permission obtained from the Conservation Division or its agents before plugging was commenced? *Yes*

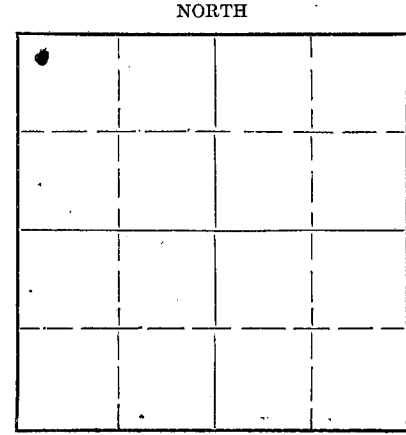

Locate well correctly on above
Section Plat

Name of Conservation Agent who supervised plugging of this well *E. Eldon Petty*

Producing formation *Conglomerate* Depth to top *3863* Bottom *3879.2* Total Depth of Well *3938* Feet

Show depth and thickness of all water, oil and gas formations.

OIL, GAS OR WATER RECORDS

CASING RECORD

Formation	Content	From	To	Size	Put In	Pulled Out
<i>Conglomerate</i>	<i>Oil + Water</i>	<i>3863</i>	<i>3892</i>	<i>8 5/8"</i>	<i>192'</i>	<i>None</i>
				<i>5 1/2"</i>	<i>3938</i>	<i>2500</i>

Describe in detail the manner in which the well was plugged, indicating where the mud fluid was placed and the method or methods used in introducing it into the hole. If cement or other plugs were used, state the character of same and depth placed, from _____ feet to _____ feet for each plug set.

*Cement in pipe up to 3906' filled with Chd up to 3840
dumped 5 sacks Cement with dump bailer. filled up to
3805' filled hole with mud. from 3805 up to 192' set
rock bridge dumped 15 sacks Cement filled up to 145'
filled with mud up to 35' set rock bridge. dumped 10
sacks Cement for Cap.*

*James + S. Helburn drilled this well in Dec. 1949. The Flynn
oil co. reopened it in April 1952. We don't have any
log on this well.*

(If additional description is necessary, use BACK of this sheet)

Correspondence regarding this well should be addressed to *Chas E. Rocky*

Address *Chas E. Rocky*

RECEIVED
STATE CORPORATION COMMISSION
12-27-1952
DEC 27 1952

CONSERVATION DIVISION
Wichita, Kansas

STATE OF *Kan*, COUNTY OF *Barton*, SS.

(employee of owner) or (owner or operator) of the above-described well,
being first duly sworn on oath, says: That I have knowledge of the facts, statements, and matters herein contained and the log of the above-
described well as filed and that the same are true and correct. So help me God

(Signature) *Chas E. Rocky*

Olga, Kans.

(Address)

SUBSCRIBED AND SWORN to before me this *26* day of *December* 19*52*

My commission expires *Jan 20, 1953.*

