

CARD MUST BE TYPED

State of Kansas
NOTICE OF INTENTION TO DRILL

CARD MUST BE SIGNED

(see rules on reverse side)

Starting Date: 11 21 85
month day year

API Number 15- 195-21,814-0000

OPERATOR: License # 5063

SE SW NW Sec 4 Twp 12 S, Rge 21 East
(location) West

Name Energy Exploration, Inc.

Address 1002 S. Broadway

City/State/Zip Wichita, Kansas 67211

Contact Person Brad D. Lehl

Phone (316) 267-7336

2970 Ft North from Southeast Corner of Section
4290 Ft West from Southeast Corner of Section
(Note: Locate well on Section Plat on reverse side)

CONTRACTOR: License # 5422

Name Abercrombie Drilling, Inc.

City/State Wichita, Kansas

Nearest lease or unit boundary line 990 feet.
County Trego

Lease Name Deutscher Well# 1

Domestic well within 330 feet: yes no

Municipal well within one mile: yes no

Well Drilled For: Well Class: Type Equipment:

- Oil Swd Infield Mud Rotary
- Gas Inj Pool Ext. Air Rotary
- OWWO Expl Wildcat Cable

Depth to Bottom of fresh water 100 feet

Lowest usable water formation ~~1000~~ Dakota

Depth to Bottom of usable water 975 feet

Surface pipe by Alternate: 1 2

Surface pipe to be set 250 feet

Conductor pipe if any required - feet

Ground surface elevation N/A feet MSL

This Authorization Expires 5-12-85

Approved By 11-12-85 RCH/KOAE

If OWWO: old well info as follows:

Operator

Well Name

Comp Date Old Total Depth

Projected Total Depth 4100 feet

Projected Formation at TD Arbuckle

Expected Producing Formations Marmaton, Arbuckle

I certify that we will comply with K.S.A. 55-101, et seq., plus eventually plugging hole to K.C.C. specifications.


Date 11-8-85 Signature of Operator or Agent [Signature] Title President

Production casing will be cemented from below usable water to surface immediately after casing is set. Form C-1 4/84

Must be filed with the K.C.C. five (5) days prior to commencing well
 This card void if drilling not started within six (6) months of date received by K.C.C.

Important procedures to follow :

A Regular Section of Land
1 Mile = 5,280 Ft.

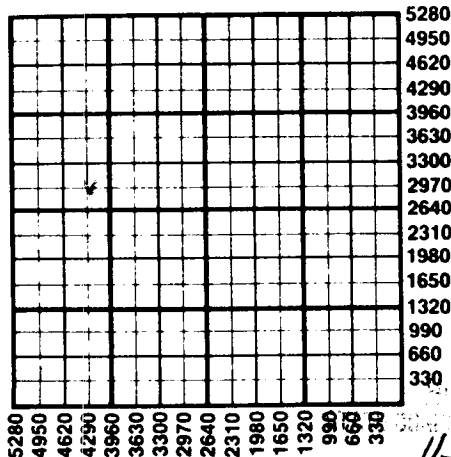

1. Notify District office before setting surface casing.
2. Set surface casing by circulating cement to the top.
3. File completion forms ACO-1 with K.C.C. within 90 days of well completion, following instructions on ACO-1, side 1, and including copies of wireline logs.
4. Notify District office 48 hours prior to old well workover or re-entry.
5. Prior to plugging, prepare a plugging plan, then obtain agreement from the appropriate district office for an approved plugging plan.
6. Submit plugging report (CP-4) to K.C.C. after plugging is completed.
7. Obtain an approved injection docket number before disposing of salt water.
8. Notify K.C.C. within 10 days when injection commences or terminates.
9. If an alternate 2 completion, cement in the production pipe from below any usable water to surface within 120 days of spud date.

11-12-1985

State Corporation Commission of Kansas
Conservation Division
200 Colorado Derby Building
Wichita, Kansas 67202
(316) 263-3238