

CARD MUST BE TYPED

State of Kansas
NOTICE OF INTENTION TO DRILL

15-1986-21786-0000
CARD MUST BE SIGNED

(see rules on reverse side)

Starting Date: 9 23 85
month day year

API Number 15-

195-21,786

OPERATOR: License # 5063

SE NE NE Sec 5 Twp 12 S, Rge 21 East West
(location)

Name Energy Exploration, Inc.

Address 1002 South Broadway

City/State/Zip Wichita, Kansas 67211

Contact Person Brad Lehl

Phone (316) 267-7336

4290 Ft North from Southeast Corner of Section

330 Ft West from Southeast Corner of Section

(Note: Locate well on Section Plat on reverse side)

CONTRACTOR: License # 5422

Name Abercrombie Drilling, Inc.

City/State 801 Union Center, Wichita, Ks. 67202

Nearest lease or unit boundary line 330 feet.

County Trego

Lease Name Armbruster Well# 1

Domestic well within 330 feet: yes no

Municipal well within one mile: yes no

Well Drilled For: Well Class: Type Equipment:

- Oil Swd Infield Mud Rotary
- Gas Inj Pool Ext. Air Rotary
- OWWO Expl Wildcat Cable

Depth to Bottom of fresh water 100 feet

Lowest usable water formation Dakota

Depth to Bottom of usable water 925 feet

Surface pipe by Alternate: 1 2

Surface pipe to be set 250 feet

Conductor pipe if any required feet

Ground surface elevation 2342 feet MSL

This Authorization Expires 3-19-86

Approved By 8-19-85

If OWWO: old well info as follows:

Operator

Well Name

Comp Date Old Total Depth

Projected Total Depth 4100 feet

Projected Formation at TD

Expected Producing Formations

I certify that we will comply with K.S.A. 55-101, et seq., plus eventually plugging hole to K.C.C. specifications.

Date 9-19-85 Signature of Operator or Agent

[Signature]

Title President

[Signature]
PCA/KOBE

If a commercial reservoir exists we will cement the long string right away from the surface. Likewise we will plug the well right away if a commercial reservoir does not exist.


RECEIVED
STATE CORPORATION COMMISSION

Must be filed with the K.C.C. five (5) days prior to commencing well
This card void if drilling not started within six (6) months of date received by K.C.C.

SEP 19 1985
9-19-1985

CONSERVATION DIVISION

Wichita, Kansas
A Regular Section of Land
1 Mile = 5,280 Ft.

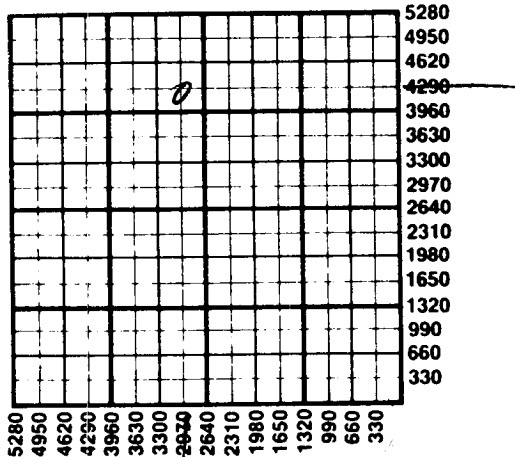

Important procedures to follow :

1. Notify District office before setting surface casing.
2. Set surface casing by circulating cement to the top.
3. File completion forms ACO-1 with K.C.C. within 90 days of well completion, following instructions on ACO-1, side 1, and including copies of wireline logs.
4. Notify District office 48 hours prior to old well workover or re-entry.
5. Prior to plugging, prepare a plugging plan, then obtain agreement from the appropriate district office for an approved plugging plan.
6. Submit plugging report (CP-4) to K.C.C. after plugging is completed.
7. Obtain an approved injection docket number before disposing of salt water.
8. Notify K.C.C. within 10 days when injection commences or terminates.
9. If an alternate 2 completion, cement in the production pipe from below any usable water to surface within 120 days of spud date.

State Corporation Commission of Kansas
Conservation Division
200 Colorado Derby Building
Wichita, Kansas 67202
(316) 263-3238