

CARD MUST BE TYPED

NOTICE OF INTENTION TO DRILL

State of Kansas
(see rules on reverse side)

Collective
CARD MUST BE SIGNED

Starting Date: September 6, 1985
month day year

API Number 15- 195-21,778-00-00
9-9

OPERATOR: License # 5238
Name Petroleum, Inc.
Address 300 W. Douglas Suite 800
City/State/Zip Wichita, Kansas 67202
Contact Person Monte Chadd
Phone (316) 793-8471

NW SW NE Sec 4 Twp 12 S, Rge 21
(location) East West

3630' Ft North from Southeast Corner of Section
2310' Ft West from Southeast Corner of Section
(Note: Locate well on Section Plat on reverse side)

CONTRACTOR: License # 5135
Name John O. Farmer, Inc.
City/State Russell, Kansas 67665

Nearest lease or unit boundary line 1650 feet.
County Trego
Lease Name Deutscher 'E' Well # 1

Domestic well within 330 feet: yes no
Municipal well within one mile: yes no

Well Drilled For: Well Class: Type Equipment:
 Oil Swd Infield Mud Rotary
 Gas Inj Pool Ext. Air Rotary
 OWWO Expl Wildcat Cable

Depth to Bottom of fresh water 100 feet
Lowest usable water formation Dakota
Depth to Bottom of usable water 925 feet

If OWWO: old well info as follows:
Operator
Well Name
Comp Date Old Total Depth
Projected Total Depth 4100 feet
Projected Formation at TD
Expected Producing Formations

Surface pipe by Alternate: 1 2
Surface pipe to be set 200 feet
Conductor pipe if any required -- feet
Ground surface elevation -- feet MSL

This Authorization Expires 3-2-86
Approved By 8-30-85 *[Signature]*

I certify that we will comply with K.S.A. 55-101, et seq., plus eventually plugging hole to K.C.C. specifications.

Date 8-30-85 Signature of Operator or Agent *[Signature]* Title

District Landman *[Signature]*

String will be immediately cemented from below the usable water to the surface.

Must be filed with the K.C.C. five (5) days prior to commencing well
This card void if drilling not started within six (6) months of date received by K.C.C.

RECEIVED

STATE CORPORATION COMMISSION

8-30-1985


AUG 30 1985

Important procedures to follow:

A Regular Section of Land
1 Mile = 5,280 Ft.

CONSERVATION DIVISION
Wichita, Kansas

1. Notify District office before setting surface casing.
2. Set surface casing by circulating cement to the top.
3. File completion forms ACO-1 with K.C.C. within 90 days of well completion, following instructions on ACO-1, side 1, and including copies of wireline logs.
4. Notify District office 48 hours prior to old well workover or re-entry.
5. Prior to plugging, prepare a plugging plan, then obtain agreement from the appropriate district office for an approved plugging plan.
6. Submit plugging report (CP-4) to K.C.C. after plugging is completed.
7. Obtain an approved injection docket number before disposing of salt water.
8. Notify K.C.C. within 10 days when injection commences or terminates.
9. If an alternate 2 completion, cement in the production pipe from below any usable water to surface within 120 days of spud date.

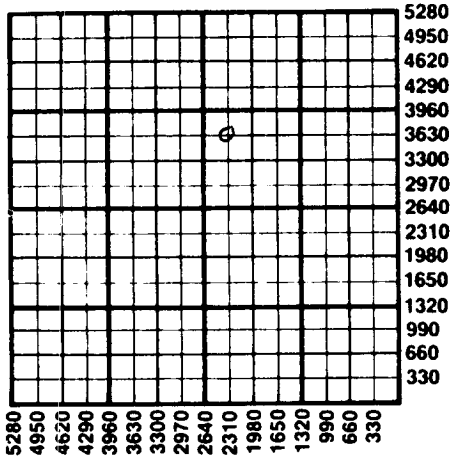

State Corporation Commission of Kansas
Conservation Division
200 Colorado Derby Building
Wichita, Kansas 67202
(316) 263-3238