

CARD MUST BE TYPED

State of Kansas
NOTICE OF INTENTION TO DRILL
 (see rules on reverse side)

CARD MUST BE SIGNED

Starting Date: 6 28 84
 month day year

API Number 15-

OPERATOR: License # 5399 \$ 5040

NE SE SW ... Sec 33 Twp 12 S, Rge 19 ... ☐ East
☒ West

Name American Energies Corporation & Alpine Drilling (location)

Address 575 Fourth Financial Center Co., Inc. 990 Ft North from Southeast Corner of Section

City/State/Zip Wichita, Kansas 67202 2970 Ft West from Southeast Corner of Section

Contact Person Mr. Alan L. DeGood (Note: Locate well on Section Plat on reverse side)

Phone (316) 263-5785 Nearest lease or unit boundary line 990 feet.

CONTRACTOR: License # 5137 County Ellis

Name J. W. Drilling Co., Inc. Lease Name Maier Well # 1

City/State Wichita, Kansas 67202

Well Drilled For: Well Class: Type Equipment:

☒ Oil ☐ Swd ☐ Infield ☒ Mud Rotary

☐ Gas ☐ Inj ☐ Pool Ext. ☐ Air Rotary

☐ OWWO ☐ Expl ☒ Wildcat ☐ Cable

If OWWO: old well info as follows:

Operator

Well Name

Comp Date Old Total Depth

Projected Total Depth 3850 feet

Projected Formation at TD Arbuckle

Expected Producing Formations Lansing and Arbuckle

Depth to Bottom of fresh water 100 feet

Lowest usable water formation Dakota

Depth to Bottom of usable water 500 800 feet

Surface pipe by Alternate: 1 ☐ 2 ☒

Surface pipe to be set 250 feet

Conductor pipe if any required None feet

Ground surface elevation N/A feet MSL

This Authorization Expires 12-20-84

Approved By 6-20-84

I certify that we will comply with K.S.A. 55-101, et seq., plus eventually plugging hole to K.C.C. specifications.


Date 6/19/84 Signature of Operator or Agent

Alan L. DeGood Title Vice-President

Must be filed with the K.C.C. five (5) days prior to commencing well
This card void if drilling not started within six (6) months of date received by K.C.C.

Important procedures to follow:

A Regular Section of Land
1 Mile = 5,280 Ft.

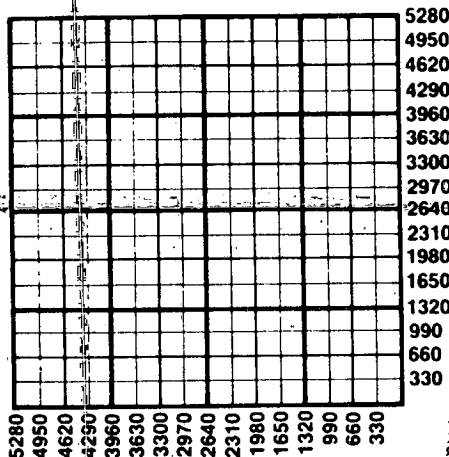

1. Notify District office before setting surface casing.
 2. Set surface casing by circulating cement to the top.
 3. File completion forms ACO-1 with K.C.C. within 90 days of well completion, following instructions on ACO-1, side 1, and including copies of wireline logs.
 4. Notify District office 48 hours prior to old well workover or re-entry.
 5. Prior to plugging, prepare a plugging plan, then obtain agreement from the appropriate district office for an approved plugging plan.
 6. Submit plugging report (CP-4) to K.C.C. after plugging is completed.
 7. Obtain an approved injection docket number before disposing of salt water.
 8. Notify K.C.C. within 10 days when injection commences or terminates.
- If alternate 2 completion, cement in the production pipe from below available water to surface within 120 days of spud date.

State Corporation Commission of Kansas
Conservation Division
200 Colorado Derby Building
Wichita, Kansas 67202
(316) 263-3238