

15-051-24042-00-00
CARD MUST BE TYPED

State of Kansas
NOTICE OF INTENTION TO DRILL
(see rules on reverse side)

****CORRECTION****
CARD MUST BE SIGNED
10-18-84

Starting Date: 10 12 84
month day year

API Number 15- 051-24,042

OPERATOR: License # 8728
Name ... ROCKHOUND RESOURCES, INC.
Address ... P. O. Box 1010
City/State/Zip ... Great Bend, Kansas 67530
Contact Person ... Rod Tremblay
Phone 316/792-8251

* 60'W of SE NE SW Sec 5 Twp 12 S, Rge 20
(location) East West

..... 1650 Ft North from Southeast Corner of Section
* 3030 Ft West from Southeast Corner of Section
(Note: Locate well on Section Plat on reverse side)

CONTRACTOR: License # 5929
Name ... DUKE DRILLING CO., INC.
City/State ... Great Bend, Kansas 67530

Nearest lease or unit boundary line 330 feet.
County Ellis
Lease Name Urban Well# 1

Well Drilled For: **Well Class:** **Type Equipment:**
 Oil Swd Infield Mud Rotary
 Gas Inj Pool Ext. Air Rotary
 OWWO Expl Wildcat Cable

Domestic well within 330 feet: yes no
Municipal well within one mile: yes no

If OWWO: old well info as follows:
Operator
Well Name
Comp Date Old Total Depth
Projected Total Depth 4000 feet
Projected Formation at TD Arbuckle
Expected Producing Formations Arbuckle

Depth to Bottom of fresh water 200 feet
Lowest usable water formation Dakota
Depth to Bottom of usable water 800 feet
Surface pipe by Alternate: 1 2
Surface pipe to be set 260 feet
Conductor pipe if any required feet
Ground surface elevation 2233 feet MSL
This Authorization Expires 3/26/85
Approved By R.C.H./K.C. ~~10-17-84~~ 9-26-84


I certify that we will comply with K.S.A. 55-101, et seq., plus eventually plugging hole to K.C.C. specifications.

Date 10/17/84 Signature of Operator or Agent *Sally R. Byers* Title Agent
Was: 2970 FEL, SE-NE-SW Sally R. Byers

Must be filed with the K.C.C. five (5) days prior to commencing well
This card void if drilling not started within six (6) months of date received by K.C.C.

RECEIVED
STATE CORPORATION COMMISSION
10-17-1984
OCT 17 1984

A Regular Section of Land
1 Mile 5,280 Ft.

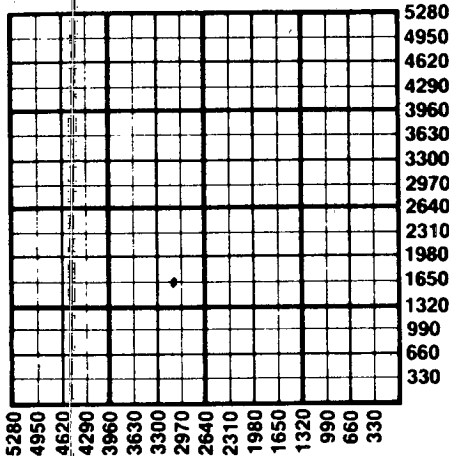

Important procedures to follow :

1. Notify District office before setting surface casing.
2. Set surface casing by circulating cement to the top.
3. File completion forms ACO-1 with K.C.C. within 90 days of well completion, following instructions on ACO-1, side 1, and including copies of wireline logs.
4. Notify District office 48 hours prior to old well workover or re-entry.
5. Prior to plugging, prepare a plugging plan, then obtain agreement from the appropriate district office for an approved plugging plan.
6. Submit plugging report (CP-4) to K.C.C. after plugging is completed.
7. Obtain an approved injection docket number before disposing of salt water.
8. Notify K.C.C. within 10 days when injection commences or terminates.
9. If an alternate 2 completion, cement in the production pipe from below any usable water to surface within 120 days of spud date.

State Corporation Commission of Kansas
Conservation Division
200 Colorado Derby Building
Wichita, Kansas 67202
(316) 263-3238