

CARD MUST BE TYPED

NOTICE OF INTENTION TO DRILL

(see rules on reverse side)

State of Kansas 15-051-24247-00-00

CARD MUST BE SIGNED

Starting Date: 5 month 30 day 85 year

API Number 15- 051-24247

OPERATOR: License # 8728
Name Rockhound Resources, Inc.
Address P.O. Box 1010
City/State/Zip Great Bend, Kansas 67530
Contact Person Rod Tremblay
Phone 316/792-8251

N/2 SW NE Sec 5 Twp 12 S, Rge 20
3630 Ft North from Southeast Corner of Section
1980 Ft West from Southeast Corner of Section
(Note: Locate well on Section Plat on reverse side)

CONTRACTOR: License # 5929
Name Duke Drilling Co., Inc.
City/State Great Bend, Kansas 67530

Nearest lease or unit boundary line 330 feet
County Ellis

Well Drilled For: Well Class: Type Equipment:
Oil Swd Infield Mud Rotary
Gas Inj Pool Ext Air Rotary
OWWO Expl Wildcat Cable

Lease Name Schmeidler Well# 2
Domestic well within 330 feet: yes no
Municipal well within one mile: yes no

If OWWO: old well info as follows:

Operator
Well Name
Comp Date Old Total Depth
Projected Total Depth 4000 feet
Projected Formation at TD Conglomerate
Expected Producing Formations Marmaton Toronto

Depth to Bottom of fresh water 100 feet
Lowest usable water formation Dakota
Depth to Bottom of usable water 900 feet
Surface pipe by Alternate: 1 2
Surface pipe to be set 200+ feet
Conductor pipe if any required feet
Ground surface elevation feet MSL
This Authorization Expires 11-29-85
Approved By 5-29-85

I certify that we will comply with K.S.A. 55-101, et seq., plus eventually plugging hole to K.C.C. specifications.

Date 5/28/85 Signature of Operator or Agent

Jane E. Bixby
Jane E. Bixby


Production string well
be cemented immediately
Title Agent
MHC/MOHE 5-29-85

Must be filed with the K.C.C. five (5) days prior to commencing well
This card void if drilling not started within six (6) months of date received by K.C.C.

RECEIVED
STATE CORPORATION COMMISSION

5-29-1985
MAY 29 1985

CONSERVATION DIVISION
Kansas
A Regular Section of Land
1 Mile = 5,280 Ft.

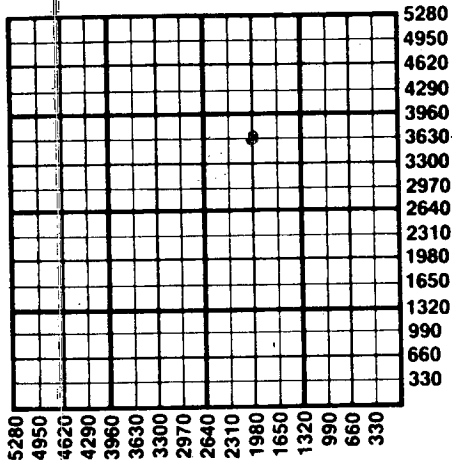

Important procedures to follow:

1. Notify District office before setting surface casing.
2. Set surface casing by circulating cement to the top.
3. File completion forms ACO-1 with K.C.C. within 90 days of well completion, following instructions on ACO-1, side 1, and including copies of wireline logs.
4. Notify District office 48 hours prior to old well workover or re-entry.
5. Prior to plugging, prepare a plugging plan, then obtain agreement from the appropriate district office for an approved plugging plan.
6. Submit plugging report (CP-4) to K.C.C. after plugging is completed.
7. Obtain an approved injection docket number before disposing of salt water.
8. Notify K.C.C. within 10 days when injection commences or terminates.
9. If an alternate 2 completion, cement in the production pipe from below any usable water to surface within 120 days of spud date.

State Corporation Commission of Kansas
Conservation Division
200 Colorado Derby Building
Wichita, Kansas 67202
(316) 263-3238