


STATE OF KANSAS
STATE CORPORATION COMMISSION

15-051-22248-00-00
WELL PLUGGING RECORD

Give All Information Completely
Make Required Affidavit
Mail or Deliver Report to
Conservation Division
State Corporation Comm.
245 North Water
Wichita, KS 67202

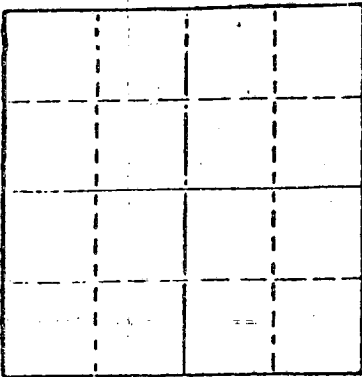

Locate well correctly on above
Section Plat

County. Sec. 17 Twp. 12S Rge. 18W E/W
Location as "NE/CNW1SW1" or footage from lines
NE SE SW

Lease Owner Green Oil Operations
Lease Name SULLIVAN Well No. #1
Office Address Rt. 1, Lot 8 - Stonewood Estates, Hays, KS 67601
Character of Well (Completed as Oil, Gas or Dry Hole)

Dry Hole
Date Well completed January 14 1981
Application for plugging filed January 14 1981
Application for plugging approved January 14 1981
Plugging commenced January 14 1981
Plugging completed January 14 1981
Reason for abandonment of well or producing formation
No commercial quantity of oil or gas encountered.
If a producing well is abandoned, date of last production 19

Was permission obtained from the Conservation Division or
its agents before plugging was commenced? Yes

Name of Conservation Agent who supervised plugging of this well Marion Schmidt
Producing formation Depth to top Bottom Total Depth of Well 3790'
Show depth and thickness of all water, oil and gas formations.

OIL, GAS OR WATER RECORDS

CASING RECORD

FORMATION	CONTENT	FROM	TO	SIZE	PUT IN	PULLED OUT

Describe in detail the manner in which the well was plugged, indicating where the mud fluid
was placed and the method or methods used in introducing it into the hold. If cement or other
plugs were used, state the character of same and depth placed, from feet to
feet for each plug set.

T.D. @ 3790'
1st Plug Set @ 840' with 70 sx.
2nd Plug Set @ 240' with 25 sx.
3rd Plug Set @ 40' Solid Bridge with 10 sx.
Rathole - 5 sx. 50-50 posmix, 6% gel.

Plug was down @ 1:45 a.m., 1/16/81.
State Plugger - Marion Schmidt

(If additional description is necessary, use BACK of this sheet)

Name of Plugging Contractor Abercrombie Drilling, Inc.

STATE OF Kansas COUNTY OF Sedgwick, ss.
Jack L. Partridge, Asst. Sec./Treas. (employee of owner) or (owner or operator)
of the above-described well, being first duly sworn on oath, says: That I have knowledge of
the facts, statements, and matters herein contained and the log of the above-described well
as filed and that the same are true and correct. So help me God.


(Signature)

801 Union Center, Wichita, KS 67202
(Address)

SUBSCRIBED AND SWORN TO before me this 20th day of January, 1981

My commission expires 8-18-84

Jeanette A. Metheny Notary Public.

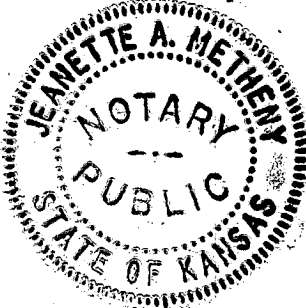

RECEIVED
STATE CORPORATION COMMISSION
1-23-1981
JAN 23 1981
CONSERVATION DIVISION
Wichita, Kansas

15-051-22248-00-00

CONTRACTOR'S WELL LOG

OPERATOR: Green Oil Operations
CONTRACTOR: Abercrombie Drilling, Inc.
WELL NAME: SULLIVAN #1
LOCATION: NE SE SW, Section 17-12S-18W
Ellis County, Kansas
SPUD DATE: 1/09/81
COMPLETION DATE: 1/16/81

0	1485	Sand & Shale
1485	1802	Anhydrite
1802	2370	Sand & Shale
2370	2605	Shale & Redbed
2605	2782	Shale & Sand
2782	3790	Lime & Shale
	3790	Rotary Total Depth

Spud hole on 1/09/81. - Drilled 253' of a 12 $\frac{1}{4}$ " hole. Ran 6 jts. of new 8 5/8" - 20# casing (tally 240.95 overall) Set @ 249' with 175 sx. of 60-40 posmix by Sun Cementing. Plug was down @ 5:00 p.m., 1/09/81. All collars strapped & welded.

T.D. @ 3790'. Set 1st Plug @ 840' with 70 sx. Set 2nd Plug @ 240' with 25 sx., Set 3rd Plug @ 40' Solid Bridge with 10 sx. Rathole with 5 sx., 50-50 posmix, 6% gel. Plug was down @ 1:45 a.m., 1/16/81. State Plugger - Marion Schmidt.

SAMPLE TOPS:

Anhydrite 1486'
B/Anhydrite 1518'

STATE OF KANSAS)
) SS
COUNTY OF SEDGWICK)

Jack L. Partridge, Assistant Secretary/Treasurer of Abercrombie Drilling, Inc., does hereby state that the above and foregoing is a true and correct copy of the log of the SULLIVAN #1, NE SE SW, Section 17-12S-18W, Ellis County, Kansas.

ABERCROMBIE DRILLING, INC.

BY: Jack L. Partridge
Jack L. Partridge, Asst. Sec./Treas.

Subscribed and sworn to before me, a Notary Public, in and for the aforesaid county and state as of this 20th day of January, 1981.

Jeanette A. Metheny
Jeanette A. Metheny, Notary Public

