


WELL PLUGGING RECORD

Give All Information Completely
Make Required Affidavit

COUNTY Ellis SEC. 8 TWP. 12S RGE. 19 NE/W
Location as in quarters or footage from lines:
NW SE SW

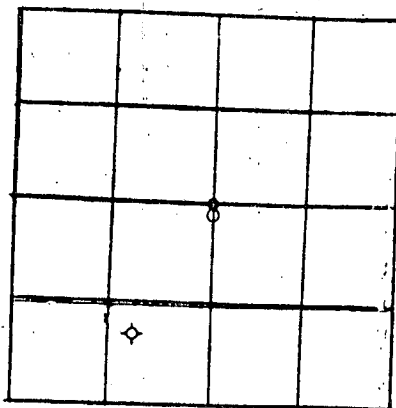

Locate Well
correctly on above
Section Platt.

Lease Owner Associates Oil & Gas, Inc.
Lease Name Massier Well No. 1
Office Address 555 N. Woodlawn, Suite 114, Wichita, KS
Character of Well (Completed as Oil, Gas or Dry Hole): dry hole
Date Well Completed December 30, 1983
Application for plugging filed December 30, 1983
Plugging commenced December 30, 1983
Plugging completed December 30, 1983
Reason for abandonment of well or producing formation dry hole

Was permission obtained from the Conservation Division or it's
Agent's before plugging was commenced? yes

Name of Conservation Agent who supervised plugging of this well Carl Goodrow
Producing formation _____ Depth to top _____ bottom _____ T.D. 3,826'

Show depth and thickness of all water, oil and gas formations.

OIL, GAS OR WATER RECORDS

Casing Record

Formation	Content	From	To	Size	Put in	Pulled Out.
				8-5/8"	205'	

Describe in detail the manner in which the well was plugged, indicating where the mud
fluid was placed and the method or methods used in introducing it into the hold. If cement
or other plugs were used, state the character of same and depth placed, from _____ feet
to _____ feet for each plug set.

Mud to 3,785', 20 sx cement	
mud to 1,575', 20 sx cement	
mud to 1,000', 100 sx cement	
1 sx flowseal	
mud to 40', 10 sx cement,	
solid bridge plug, 1 sx hulls	
10 sx in rathole	
50/50 posmix, 6% gel, no cal.	

RECEIVED
STATE CORPORATION COMMISSION
7-31-1984
JUL 31 1984
CONSERVATION DIVISION
Wichita, Kansas

(If additional description is necessary, use BACK of this sheet)

Name of Plugging Contractor Dunne - Gardner Petro. Inc

STATE OF KANSAS COUNTY OF SEDGWICK, ss.

J.D. Gebert (employee of owner) or (owner or operator) of the
above-described well, being first duly sworn on oath, says: That I have knowledge of the
facts, statements, and matters herein contained and the log of the above-described well as
filed and that the same are true and correct. So help me God.

(Signature) J.D. Gebert

555 N. WOODLAWN #114 67208
(Address)

SUBSCRIBED AND SWORN TO before me this 3rd day of January, 19 84
Cynthia L. Jackson
STATE NOTARY PUBLIC
Sedgwick County, Kansas
My Appt. Exp. _____

My Commission expires: 9-25-86

Notary Public.