


STATE OF KANSAS
STATE CORPORATION COMMISSION

Give All Information Completely
Make Required Affidavit
Mail or Deliver Report to:
Conservation Division
State Corporation Commission
800 Bitting Building
Wichita, Kansas

15-051-00718-00-00
WELL PLUGGING RECORD

NORTH

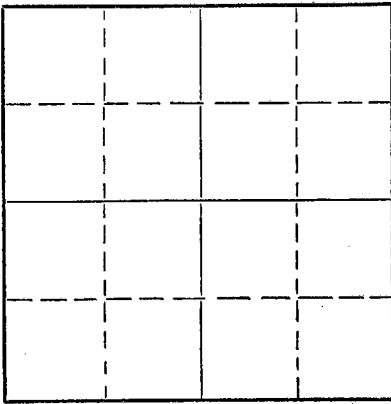

Locate well correctly on above
Section Plat

Ellis County. Sec. 7 Twp. 12S Rge. 19 (E) W (W)
Location as "NE/CNW/SW" or footage from lines C of NE NE NW
Lease Owner Kantor-Anschutz
Lease Name Hagen Well No. 1
Office Address Box 846 - Tulsa, Oklahoma
Character of Well (completed as Oil, Gas or Dry Hole) Dry Hole
Date well completed June 6, 19 54
Application for plugging filed June 6 19 54
Application for plugging approved June 6 19 54
Plugging commenced June 6 19 54
Plugging completed June 6 19 54
Reason for abandonment of well or producing formation Dry Hole

If a producing well is abandoned, date of last production 19
Was permission obtained from the Conservation Division or its agents before plugging was commenced? Yes

Name of Conservation Agent who supervised plugging of this well Eldon Petty, Hay, Kansas.
Producing formation _____ Depth to top _____ Bottom _____ Total Depth of Well _____ Feet
Show depth and thickness of all water, oil and gas formations.

OIL, GAS OR WATER RECORDS

CASING RECORD

FORMATION	CONTENT	FROM	TO	SIZE	PUT IN	PULLED OUT
				8 5/8"	248'	

Describe in detail the manner in which the well was plugged, indicating where the mud fluid was placed and the method or methods used in introducing it into the hole. If cement or other plugs were used, state the character of same and depth placed, from _____ feet to _____ feet for each plug set.

#1 Plug set @ 240' with 15 sacks of cement & 1/2 sack hulls.

#1 Plug set @ 40' with 10 sacks of cement & 1/2 sack hulls.

RECEIVED
STATE CORPORATION COMMISSION
6-19-1954
JUN 19 1954

CONSERVATION DIVISION
Wichita, Kansas


(If additional description is necessary, use BACK of this sheet)
Name of Plugging Contractor Anschutz Drilling Co., Inc.
Address 706 Union National Bank Building

STATE OF Kansas, COUNTY OF Sedgwick, ss.
E. G. Koelling (employee of owner) or (owner or operator) of the above-described well, being first duly sworn on oath, says: That I have knowledge of the facts, statements, and matters herein contained and the log of the above-described well as filed and that the same are true and correct. So help me God.

(Signature) *E. G. Koelling*
706 Union National Bank Building
(Address)

SUBSCRIBED AND SWORN to before me this 16th day of June, 19 54
March 21, 1955.

Oliver Carter
Notary Public.

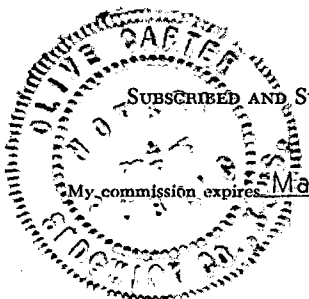

PLUGGING
FILE SEC 7 T 12 R 19W
BOOK PAGE 40 LINE 2

15-051-00778-00-00

DRILLER'S LOG

Kantor-Anschutz
Hagen #1
C of NE NE NW 7-12S-19W
Ellis County, Kansas

TO	FROM	DESCRIPTION
0	40	Surface Soil & Clay
40	250	Lime & Shale
250	675	Shale & Shells
675	905	Sand & Shale
905	1050	Shale, Shells & Sand Stks.
1050	1300	Sand
1300	1590	Red Bed
1590	1635	Anhydrite
1635	1705	Shale & Red Bed
1705	1750	Shale, Shells & Red Bed
1750	2230	Shale & Shells
2230	2350	Lime & Shale
2350	2430	Lime
2430	2570	Shale & Lime
2570	2680	Lime & Shale
2680	2715	Shale & Lime Stks.
2715	2730	Shale
2730	2760	Sand
2760	2870	Lime (Broken)
2870	2945	Lime & Shale
2945	3020	Sandy Shale & Lime
3020	3090	Shale & Shells
3090	3285	Lime & Shale
3285	3339	Lime
3339	3440	Lime & Shale
3440	3560	Lime
3560	3590	Lime (cherty)
3590	3778	Lime
3778	3815	Red Bed, Shale & Lime
3815	3830	Shale & Lime (Marmoron)
3830	3850	Simpson
3850	3893	Conglomerate
	3893	ROTARY TOTAL DEPTH D & A

STATE OF KANSAS)
COUNTY OF SEDGWICK)

I hereby affirm that the above and foregoing is a true and correct copy of the log of the Hagen #1 located C of NE NE NW of Section 7-12S-19W, Ellis County, Kansas.

ANSCHUTZ DRILLING CO., INC.

BY: E. L. Koelling
E. L. Koelling



My Commission Expires: March 21, 1955.

Oliver Carter
Notary Public
REGISTRATION COMMISSION
6-18-1954
JUN 13 1954

PLUGGING
FILE SEC 7 T 12 R 19W
BOOK PAGE 40 LINE 2

RESERVATION DIVISION
Wichita, Kansas