


STATE OF KANSAS
STATE CORPORATION COMMISSION

15-051-22088-00-00
WELL PLUGGING RECORD

Give All Information Completely
Make Required Affidavit
Mail or Deliver Report to
Conservation Division
State Corporation Comm.
245 North Water
Wichita, KS 67202

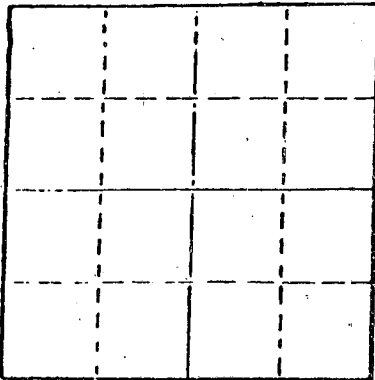

Locate well correctly on above
Section Plat

Ellis County. Sec. 6 Twp. 12s Rge. 19w E/W
Location as "NE/CNW1SW1" or footage from lines
NW SW SE

Lease Owner Mai Operations
Lease Name Massier Well No. 1
Office Address Box 33 Russell, Kansas 67665
Character of Well (Completed as Oil, Gas or Dry Hole)
dry hole

Date Well completed 10-29-80 19
Application for plugging filed 10-29-80 19
Application for plugging approved 10-29-80 19
Plugging commenced 7:00 P. M. 10-29-80 19
Plugging completed 9:00 P. M. 10-29-80 19
Reason for abandonment of well or producing formation

If a producing well is abandoned, date of last production 19

Was permission obtained from the Conservation Division or
its agents before plugging was commenced? Yes

Name of Conservation Agent who supervised plugging of this well Marion Schmidt
Producing formation Depth to top Bottom Total Depth of Well
Show depth and thickness of all water, oil and gas formations.

OIL, GAS OR WATER RECORDS

CASING RECORD

FORMATION	CONTENT	FROM	TO	SIZE	PUT IN	PULLED OUT

Describe in detail the manner in which the well was plugged, indicating where the mud fluid
was placed and the method or methods used in introducing it into the hold. If cement or other
plugs were used, state the character of same and depth placed, from feet to
feet for each plug set.

1st plug set at 650' with 60 sacks
2nd plug set at 330' with 30 sacks
solid bridge at 40' with 10 sacks
rathole 5 sacks
Total 105 sacks of 50/50 poz 6% gel

RECEIVED
STATE CORPORATION COMMISSION
NOV 3 1980
CONSERVATION DIVISION
Wichita, Kansas

(If additional description is necessary, use BACK of this sheet)

Name of Plugging Contractor Lawbanco Drilling, Inc.
Box 289 Natoma, Kansas 67651


STATE OF Kansas COUNTY OF Osborne, ss.
R. L. Finnesy (employee of owner) or (owner or operator)
of the above-described well, being first duly sworn on oath, says: That I have knowledge of
the facts, statements, and matters herein contained and the log of the above-described well
as filed and that the same are true and correct. So help me God.

(Signature) R. L. Finnesy
306 N. Section Line Plainville, Kansas
(Address)

SUBSCRIBED AND SWORN TO before me this 31st day of October, 1980


Linda A. Zeigler
Notary Public.

My commission expires 8-29-83

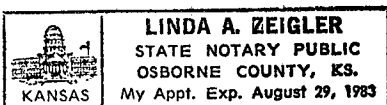

15-051-22088-00-00

KANSAS

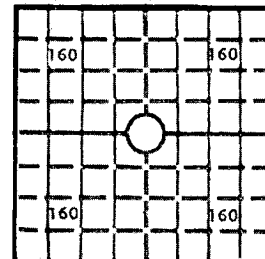WELL COMPLETION REPORT AND
DRILLER'S LOGAPI No. 15 — Ellis — 051-22,088
County NumberS. 6 T. 12s R. 19w ^E_WLoc. NW¹SW¹SECounty Ellis640 Acres
N

Locate well correctly

Elev.: Gr. 2186DF 2188 KB 2191

Operator

Mai Operations

Address

Box 33 Russell, Kansas 67665

Well No.

1

Lease Name

Massier

Footage Location

feet from (N) (S) line

feet from (E) (W) line

Principal Contractor

Lawbanco Drilling, Inc.

Geologist

Roy Krueger

Spud Date

10-22-80

Date Completed

10-29-80

Total Depth

3791

P.B.T.D.

Directional Deviation

Oil and/or Gas Purchaser

CASING RECORD

Report of all strings set — surface, intermediate, production, etc.

Purpose of string	Size hole drilled	Size casing set (in O.D.)	Weight lbs/ft.	Setting depth	Type cement	Sacks	Type and percent additives
Surface	12 $\frac{1}{4}$	8 5/8	24	330'	common	175	Quikset

LINER RECORD

PERFORATION RECORD

Top, ft.	Bottom, ft.	Sacks cement	Shots per ft.	Size & type	Depth interval

TUBING RECORD

Size	Setting depth	Packer set at

ACID, FRACTURE, SHOT, CEMENT SQUEEZE RECORD

Amount and kind of material used	Depth interval treated

INITIAL PRODUCTION

Date of first production		Producing method (flowing, pumping, gas lift, etc.)			
RATE OF PRODUCTION PER 24 HOURS	Oil	Gas	Water	Gas-oil ratio	
	bbls.	MCF	bbls.	CFPB	
Disposition of gas (vented, used on lease or sold)			Producing interval (s)		

INSTRUCTIONS: As provided in KCC Rule 82-2-125, within 90 days after completion of a well, one completed copy of this Drillers Log shall be transmitted to the State Geological Survey of Kansas, 4150 Monroe Street, Wichita, Kansas 67209. Copies of this form are available from the Conservation Division, State Corporation Commission, 245 No. Water, Wichita, Kansas 67202. Phone AC 316-522-2206. If confidential custody is desired, please note Rule 82-2-125. Drillers Logs will be on open file in the Oil and Gas Division, State Geological Survey of Kansas, Lawrence, Kansas 66044.

Operator Mai Operations		DESIGNATE TYPE OF COMP.: OIL, GAS, DRY HOLE, SWDW, ETC.: dry hole
Well No. 1	Lease Name Massier	
S 6 T 12 R 19 ^E _W		NW SW SE

WELL LOG

Show all important zones of porosity and contents thereof; cored intervals, and all drill-stem tests, including depth interval tested, cushion used, time tool open, flowing and shut-in pressures, and recoveries.

SHOW GEOLOGICAL MARKERS, LOGS RUN, OR OTHER DESCRIPTIVE INFORMATION.

FORMATION DESCRIPTION, CONTENTS, ETC.	TOP	BOTTOM	NAME	DEPTH
0 to 333 Surface dirt, rock and shale				
330 to 1552 Sand and shale				
1552 to 1598 Anhydrite				
1598 to 2510 Shale and shells				
2510 to 2704 Shale				
2704 to 2903 Shale and shells				
2903 to 3090 Shale and lime				
3090 to 3465 Shale and lime				
3465 to 3560 Shale and lime				
3560 to 3791 Shale and lime RTD				

USE ADDITIONAL SHEETS, IF NECESSARY, TO COMPLETE WELL RECORD.

RECEIVED
STATE CORPORATION COMMISSION
11-3-1980
NW - 3 1980

Date Received	<i>R. T. Farnsworth</i> CONSERVATION DIVISION Wichita, Kansas Drilling Superintendent Title October 31, 1980 Date
---------------	--