

TYPE

15-051-23546-00-00
AFFIDAVIT OF COMPLETION FORM

ACO-1 WELL HISTORY

Compt. _____

SIDE ONE

(Rules 82-3-130 and 82-3-107)

This form shall be filed with the Kansas Corporation Commission, 200 Colorado Derby Building, Wichita, Kansas 67202, within ninety (90) days after the completion of a well, regardless of how the well was completed.

FOR INFORMATION REGARDING THE NUMBER OF COPIES TO BE FILED AND APPLICATIONS REQUIRING COPIES OF ACO-1 FORMS SEE PAGE TWO (2), SIDE TWO (2) OF THIS FORM.

F _____ Letter requesting confidentiality attached.

C _____ Attach ONE COPY of EACH wireline log run (i.e. electrical log, sonic log, gamma ray neutron log etc.)***Check here if NO logs were run ☒.

PLEASE FILL IN ALL INFORMATION. IF NOT AVAILABLE, INDICATE. IF INFORMATION LATER BECOMES AVAILABLE, SUBMIT BY LETTER.

LICENSE # 5329 EXPIRATION DATE 6-30-84

OPERATOR Dreiling Resources, Inc. API NO. 15-051-23,546

ADDRESS P. O. Box 278 COUNTY Ellis

Victoria, KS 67671 FIELD WILDCAT

** CONTACT PERSON ALFRED J. DREILING PROD. FORMATION _____

PHONE 913 735 9225

PURCHASER _____ LEASE Leiker

ADDRESS _____ WELL NO. 1

DRILLING Dreiling Oil, Inc. WELL LOCATION C W/2 SW/4 SE/4

CONTRACTOR Box 1000 660 Ft. from South Line and

ADDRESS Victoria, KS 67671 2310 Ft. from East Line of

PLUGGING Dreiling Oil, Inc. the SE (Qtr.) SEC 34 TWP 12 RGE 19 (E)

CONTRACTOR Box 1000 (W)

ADDRESS Victoria, KS 67671

TOTAL DEPTH 3740' PBTD _____

SPUD DATE 7-25-83 DATE COMPLETED 7-30-83

ELEV: GR 2119' DF 2121' KB 2124'


DRILLED WITH (CABLE) (ROTARY) (AIR) TOOLS.

DOCKET NO. OF DISPOSAL OR REPRESSURING WELL BEING USED TO DISPOSE OF WATER FROM THIS LEASE _____

Amount of surface pipe set and cemented 167' DV Tool Used? _____

TYPE OF COMPLETION THIS AFFIDAVIT APPLIES TO: (Circle ONE) - Oil, Shut-in Gas, Gas, Dry, Disposal, Injection, Temporarily Abandoned. If OWWO, indicate type of re-completion _____. Other completion _____. NGPA filing _____

WELL PLAT _____ (Office Use Only)

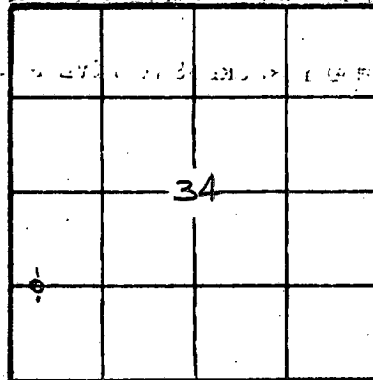

KCC ☒

KGS ☒

SWD/REP _____

PLG. ☒

NGPA _____

A F F I D A V I T


ALFRED J. DREILING, being of lawful age, hereby certifies that:

I am the Affiant, and I am familiar with the contents of the foregoing Affidavit. The statements and allegations contained therein are true and correct.

SUBSCRIBED AND SWORN TO BEFORE ME this

24th

day of

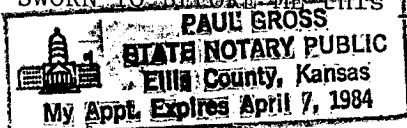August19 83.

MY COMMISSION EXPIRES: April 7, 1984

RECEIVED (NOTARY PUBLIC)
STATE CORPORATION COMMISSION

8-25-1983
AUG 25 1983

** The person who can be reached by phone regarding any questions concerning this information.

CONSERVATION DIVISION
- Wichita, Kansas

