

STATE OF KANSAS
STATE CORPORATION COMMISSION


Give All Information Completely
Make Required Affidavit
Mail or Deliver Report to:
Conservation Division
State Corporation Commission
800 Bitting Building
Wichita, Kansas

00158 kcc
15-051-01063-00-00
WELL PLUGGING RECORD

Ellis County. Sec. 8 Twp. 12 Rge. 19 (E) W (W)

Location as "NE/CNW/SW" or footage from lines NE NE NE
Lease Owner J. Stewart Bailey
Lease Name Spreen Well No. 1
Office Address 336 North Ridgewood Drive, Wichita, Kansas
Character of Well (completed as Oil, Gas or Dry Hole) Dry Hole
Date well completed 5-7 1955
Application for plugging filed 5-7 1955
Application for plugging approved 5-7 1955
Plugging commenced 5-7 1955
Plugging completed 5-7 1955
Reason for abandonment of well or producing formation Dry

NORTH

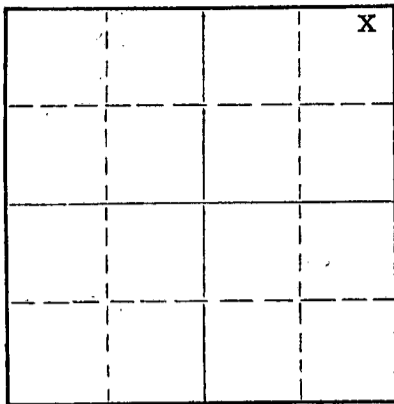

Locate well correctly on above
Section Plat

If a producing well is abandoned, date of last production _____ 19____
Was permission obtained from the Conservation Division or its agents before plugging was commenced? yes

Name of Conservation Agent who supervised plugging of this well Eldon Petty
Producing formation _____ Depth to top _____ Bottom _____ Total Depth of Well 3756 Feet
Show depth and thickness of all water, oil and gas formations.

OIL, GAS OR WATER RECORDS

CASING RECORD

FORMATION	CONTENT	FROM	TO	SIZE	PUT IN	PULLED OUT
				8 5/8	204	0

Describe in detail the manner in which the well was plugged, indicating where the mud fluid was placed and the method or methods used in introducing it into the hole. If cement or other plugs were used, state the character of same and depth placed, from _____ feet to _____ feet for each plug set.

Bottom plug @ 630 feet set with 25 sacks of cement.
Next plug @ 190 feet set with 15 sacks cement.
Top plug @ 40 feet set with 10 sacks cement.

(If additional description is necessary, use BACK of this sheet)


Name of Plugging Contractor Schafer Drilling Co.
Address Box 350, Pratt, Kansas

STATE OF Kansas, COUNTY OF Pratt, ss.
James E. Selby (employee of owner) or (owner or operator) of the above-described well, being first duly sworn on oath, says: That I have knowledge of the facts, statements, and matters herein contained and the log of the above-described well as filed and that the same are true and correct. So help me God.

(Signature) James E. Selby
Pratt, Kansas (Address)

SUBSCRIBED AND SWORN to before me this 8th day of May, 1955

My commission expires: June 30, 1955

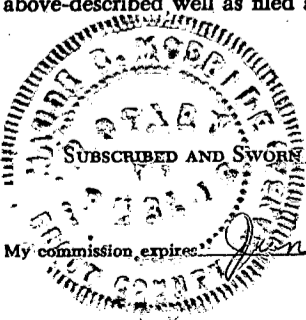

Maudie B McBride
Notary Public.

PLUGGING
FILE SEC 8 T 12 R 1955
BOOK PAGE 117 LINE 23

RECEIVED
STATE CORPORATION COMMISSION
MAY 12 1955
CONSERVATION DIVISION
Wichita, Kansas

00158 KCC
15-051-04063-00-00

**DRILLERS LOG
SPREEN #1
ELLIS COUNTY, KANSAS**

0-204	Shale
204-1465	Shale and Sand
1465-1495	Anhydrite
1495-2230	Shale and Shell
2230-2395	Shale
2395-3120	Lime and Shale
3120-3300	Lime
3300-3360	Lime and Shale
3360-3630	Lime
3630-3675	Lime and Conglomerate
3675-3725	Conglomerate
3725-3756	Conglomerate and Arbuckle Lime
3756	TOTAL DEPTH

I certify that the above drillers log is true and correct as taken from the daily drilling reports of the Spreen #1.

James G. Selby
James G. Selby, Schafer Drilling Co.

State of Kansas: County of Pratt: SS

The above was subscribed and sworn to before me this 8th day of May 1955.

Maude B. McBride
Maude B. McBride, Notary Public

My commission expires June 30, 1955.



5-12-1955
REGISTRATION DIVISION
STATE OF KANSAS

PLUGGING
PAGE 8 T 12 R 19W
BOOK PAGE 117 LINE 23