


STATE OF KANSAS  
STATE CORPORATION COMMISSION

WELL PLUGGING RECORD

Give All Information Completely  
Make Required Affidavit  
Mail or Deliver Report to  
Conservation Division  
State Corporation Comm.  
245 North Water  
Wichita, KS 67202

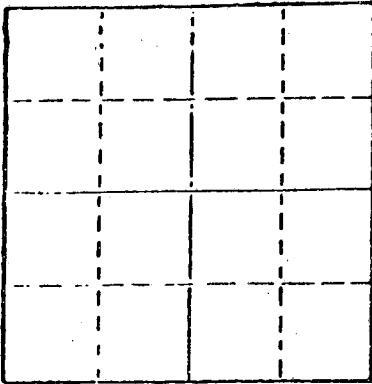

Locate well correctly on above  
Section Plat

Ellis County, Sec. 27 Twp. 12S Rge. 20W E/W  
Location as "NE/CNW $\frac{1}{4}$ SW $\frac{1}{4}$ " or footage from lines  
SE/4 SE/4 SW/4

Lease Owner Frontier Oil Company  
Lease Name Schneller "A" Well No. 1  
Office Address 1720 KSB&T Building, Wichita, Kansas 67202  
Character of Well (Completed as Oil, Gas or Dry Hole) \_\_\_\_\_

D & A  
Date Well completed May 27, 1978  
Application for plugging filed May 28, 1978  
Application for plugging approved May 28, 1978  
Plugging commenced May 28, 1978  
Plugging completed May 28, 1978  
Reason for abandonment of well or producing formation \_\_\_\_\_  
D & A

If a producing well is abandoned, date of last production \_\_\_\_\_  
19\_\_

Was permission obtained from the Conservation Division or  
its agents before plugging was commenced? Yes \_\_\_\_\_

Name of Conservation Agent who supervised plugging of this well Leo F. Massey  
Producing formation \_\_\_\_\_ Depth to top \_\_\_\_\_ Bottom \_\_\_\_\_ Total Depth of Well 3,880'  
Show depth and thickness of all water, oil and gas formations.

OIL, GAS OR WATER RECORDS

CASING RECORD

FORMATION	CONTENT	FROM	TO	SIZE	PUT IN	PULLED OUT
				8 5/8"	258.64'	-0-

Describe in detail the manner in which the well was plugged, indicating where the mud fluid  
was placed and the method or methods used in introducing it into the hold. If cement or other  
plugs were used, state the character of same and depth placed, from \_\_\_\_\_ feet to  
\_\_\_\_\_ feet for each plug set.

Plug @ 600' w/70 sx cement  
Plug @ 240' w/20 sx cement  
Plug @ 40' w/1/2 sx hulls, 10 sx cement  
(Cement was 50-50 Pozmix, 6% Gel)

RECEIVED  
STATE CORPORATION COMMISSION  
6-9-1978  
JUN 9 1978

CONSERVATION DIVISION  
Wichita, Kansas

(If additional description is necessary, use BACK of this sheet)

Name of Plugging Contractor Red Tiger Drilling Company  
1720 KSB&T Building, Wichita, Kansas 67202

STATE OF Kansas COUNTY OF Sedgwick, ss.  
Gloria Fawcett (employee of owner)


of the above-described well, being first duly sworn on oath, says: That I have knowledge of  
the facts, statements, and matters herein contained and the log of the above-described well  
as filed and that the same are true and correct. So help me God.

(Signature) Gloria Fawcett  
1720 KSB&T Building, Wichita, Kansas 67202  
(Address)

SUBSCRIBED AND SWORN TO before me this 31st day of May, 1978.

Joyce A. Hagermann  
Notary Public.

My commission expires \_\_\_\_\_

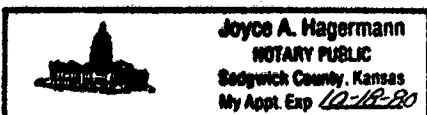

DRILLERS LOG

No. 1 Schneller "A"

CASING RECORD:	COMPANY: Frontier Oil Company	DESCRIPTION:
8 5/8" @ 266.34' w/175 sx cement	CONTRACTOR: Red Tiger Drilling Company	SE/4 SE/4 SW/4 Sec. 27-T12S-R20W Ellis County, Kansas
	COMMENCED: May 15, 1978	
	COMPLETED: May 28, 1978	
TOTAL DEPTH: 3,880'		ELEVATION: 2,178' KB

<u>FORMATION</u>	<u>FROM</u>	<u>TO</u>	<u>REMARKS</u>
Surface Soil & Rock	0	60	
Shale	60	1024	
Sand	1024	1242	
Shale & Red Bed	1242	1410	
Red Bed	1410	1557	
Anhydrite	1557	1596	
Shale	1596	2040	
Lime & Shale	2040	3249	
Lime	3249	3765	
Lime & Shale	3765	3805	
Lime	3805	3880	
RTD		3880	

RECEIVED  
STATE CORPORATION COMMISSION  
6-9-1978  
JUN 09 1978  
CONSERVATION DIVISION  
Wichita, Kansas

I certify that this is a true and correct copy of the above log to the best of my knowledge.

RED TIGER DRILLING COMPANY

Gloria Fawcett  
Gloria Fawcett

Subscribed and sworn to before me this 31st day of May, 1978.

Joyce A. Hagermann  
Notary Public

