


All Information Completely
Required Affidavit
or Deliver Report to:
Conservation Division
State Corporation Commission
212 No. Market
Wichita, Kansas

WELL PLUGGING RECORD

ESS 10/5/09 KCC

Ellis County, Sec. ²⁴23 Twp. 12 Rge. 20XXX (W)
Location as "NE/CNW&SWX" or footage from lines NW SW SW
Lease Owner Cla-Mar Oil Company
Lease Name Raymond Well No. 1
Office Address 2705 Vine St. Hays, Ks. 67601
Character of Well (completed as Oil, Gas or Dry Hole) Dry Hole
Date well completed 4-26 19 83
Application for plugging filed 4-26 19 83
Application for plugging approved 4-26 19 83
Plugging commenced 4-26 19 83
Plugging completed 4-26 19 83
Reason for abandonment of well or producing formation Dry Hole

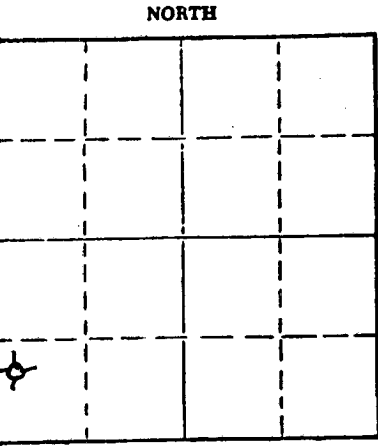

If a producing well is abandoned, date of last production 19
Was permission obtained from the Conservation Division or its agents before plugging was commenced? Yes

Name of Conservation Agent who supervised plugging of this well Gilbert Scheck
Producing formation Depth to top Bottom Total Depth of Well 3921' Feet
How deep and thickness of all water, oil and gas formations.

OIL, GAS OR WATER RECORDS

CASING RECORD

FORMATION	CONTENT	FROM	TO	SIZE	PUT IN	PULLED OUT
Surface		0	208	8 5/8"	208	0

Describe in detail the manner in which the well was plugged, indicating where the mud fluid was placed and the method or methods used introducing it into the hole. If cement or other plugs were used, state the character of same and depth placed, from feet to feet for each plug set.

- 1st. Plug set at 3921' with 20 sacks common cement 50-50 Poz 6% Gel 3% Cal cl
- 2nd. Plug set at 1600' with 20 sacks common cement 50-50 Poz 6% Gel 3% Cal cl
- 3rd. Plug set at 850' with 80 sacks common cement 50-50 Poz 6% Gel 3% Cal cl
- 4th Plug set at 220' with 40 sacks common cement 50-50 Poz 6% Gel 3% Cal cl
- 5th. Plug set at 40' with 10 sacks common cement 50-50 Poz 6% Gel 3% Cal cl
- 10 sacks in rathole
- heavy drilling mud between each plug

(If additional description is necessary, use BACK of this sheet)

Name of Plugging Contractor Allied Cementing
Address Russell, Ks.

STATE OF Kansas, COUNTY OF Graham, ss.
Jerry M. Helberg (employee of owner) or (owner or operator) of the above-described

well, being first duly sworn on oath, says: That I have knowledge of the facts, statements, and matters herein contained and the log of the above-described well as filed and that the same are true and correct. So help me God.

(Signature) Jerry M. Helberg

Box 32 Morland, Ks. 67650
(Address)

Subscribed and sworn to before me this 9th day of May, 1983
October 13, 1986

Notary Public
Signature: Pamela E. Morrison

RECEIVED
STATE CORPORATION COMMISSION
5-16-1983
MAY 16 1983