

WELL PLUGGING RECORD

Give All Information Completely
Make Required Affidavit
Mail or Deliver Report to:
Conservation Division
State Corporation Commission
800 Bitting Building
Wichita, Kansas

Trego County. Sec. 2 Twp. 12 Rge. 21 (E) W (W)

Location as "NE/CNW/SW" or footage from lines NE/4 NE/4 SW/4

Lease Owner Transit Corporation & Davis Brothers

Lease Name Schaefer Well No. 1

Office Address 1516 Liberty Bank Bldg., Okla. City, Okla.

Character of Well (completed as Oil, Gas or Dry Hole) Dry Hole

Date well completed 7-23-1953

Application for plugging filed 7-23-1953

Application for plugging approved 7-23-1953


Plugging commenced 7-23-1953

Plugging completed 7-23-1953

Reason for abandonment of well or producing formation

If a producing well is abandoned, date of last production 19

Was permission obtained from the Conservation Division or its agents before plugging was commenced? Yes

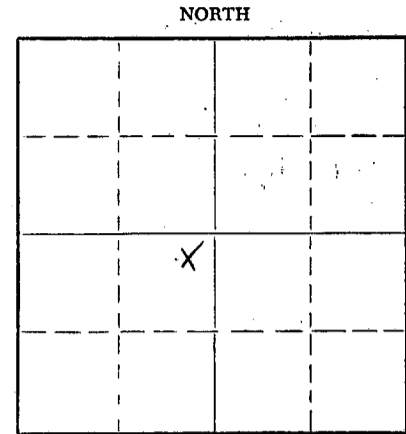

Locate well correctly on above Section Plat

Name of Conservation Agent who supervised plugging of this well Eldon Petty, Hayes, Kansas

Producing formation Depth to top Bottom Total Depth of Well 4020 Feet

Show depth and thickness of all water, oil and gas formations.


OIL, GAS OR WATER RECORDS

CASING RECORD

FORMATION	CONTENT	FROM	TO	SIZE	PUT IN	PULLED OUT
				8-5/8"	185'	None

Describe in detail the manner in which the well was plugged, indicating where the mud fluid was placed and the method or methods used in introducing it into the hole. If cement or other plugs were used, state the character of same and depth placed, from feet to feet for each plug set.

Filled hole to 163' with heavy drilling mud set plug and cemented with 15 sacks cement.
Filled hole to 45' with heavy drilling mud set plug and cemented to bottom of cellar with 10 sacks cement.

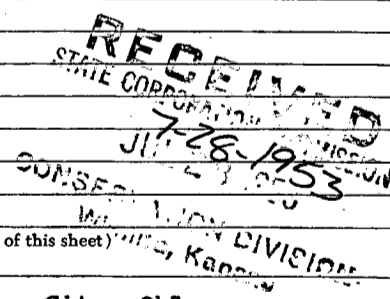

Name of Plugging Contractor Transit Corporation
Address 1516 Liberty Bank Bldg., Okla. City, Okla.

STATE OF Oklahoma, COUNTY OF Oklahoma, ss.
L. J. Kruse (employee of owner) or (owner) of the above-described well, being first duly sworn on oath, says: That I have knowledge of the facts, statements, and matters herein contained and the log of the above-described well as filed and that the same are true and correct. So help me God.
(Signature) L. J. Kruse
Okla. City, Okla.
(Address)

SUBSCRIBED AND SWORN TO before me this 27 day of July, 19 53
Notary Public.

My commission expires Feb. 14, 1957

PLUGGING
FILE SEC 2 T 12 R 21 W
BOOK PAGE 117 LINE 26

15-195-00046-00-00

TRANSIT CORPORATION -DAVIS BROTHERS

SCHAEFER # 1

NE NE SW Section 2-12S-21W
Trego Co., Kansas

ELEVATION: 2311 DF
2309 Gr.
COMMENCED: 7-7-53
COMPLETED: 7-23-53

<u>FORMATION</u>	<u>FROM</u>	<u>TO</u>	
Surface Clay	0	50	
Sandy	50	70	
Sand & Shells	70	182	8-5/8" CSA at 182'.
Cementix	130		Cemented with 125 sacks cement
Shale & Sand	182	1019	
Shale & Sand	1019	1400	
Shale, Shells, Red Bed	1400	1540	
Shells & Red Bed	1540	1740	
Anhydrite	1740	1795	
Shale & Shells	1795	2330	
Shale & Lime	2330	2700	
Lime	2700	2775	
Lime & Shale	2775	3037	
Shale	3037	3068	
Lime & Shale	3068	3400	
Lime	3400	3490	
Lime & Shale	3490	3536	
Lime	3536	3585	
Lime & Shale	3585	3661	
Lime	3661	3737	
Lime & Shale	3737	3788	
Lime	3788	3806	
Lime & Shale	3806	3923	
Cherty Lime	3923	3938	
Lime	3938	3973	
Lime	3973	4020	
Total Depth		4020	

7-28-1953

DRY HOLE

I hereby certify the foregoing to be a true and accurate Driller's Log of the formations encountered in the above well.

PLUGGING
 FILE SEC B T 12 R 21W
 PAGE 117 LINE 26

TRANSIT CORPORATION

By: L. J. Kruse
L. J. Kruse, President

Subscribed and sworn to before me this 27th day of July, 1953.

My commission expires Feb. 14, 1957.

Evelyn Culver
Evelyn Culver, Notary Public