

CARD MUST BE TYPED

State of Kansas  
**NOTICE OF INTENTION TO DRILL**

CARD MUST BE SIGNED

(see rules on reverse side)

Starting Date: October 25, 1984  
month day year

API Number 15- 195-21,622-00-00

OPERATOR: License # 6346  
Name: Pardners Investment Properties, Corp.  
Address: 2705 Vine Suite 8  
City/State/Zip: Hyas, Kansas  
Contact Person: Paul A. Montoia  
Phone: 913 628 1761

NW/2 SW NW Sec 28 Twp 12 S, Rge 21  
(location)  
3300 Ft North from Southeast Corner of Section  
4950 Ft West from Southeast Corner of Section  
(Note: Locate well on Section Plat on reverse side)

CONTRACTOR: License #  
Name: Unknown  
City/State:

Nearest lease or unit boundary line 330 feet.  
County: Trego  
Lease Name: Schoenthaler Well# 1-28

Well Drilled For: Well Class: Type Equipment:  
 Oil  Swd  Infield  Mud Rotary  
 Gas  Inj  Pool Ext.  Air Rotary  
 OWWO  Expl  Wildcat  Cable

Domestic well within 330 feet:  yes  no  
Municipal well within one mile:  yes  no

If OWWO: old well info as follows:  
Operator:  
Well Name:  
Comp Date: Old Total Depth:  
Projected Total Depth: 4000 feet  
Projected Formation at TD: Marmaton  
Expected Producing Formations: Lansing

Depth to Bottom of fresh water: ~~880000~~ 130 feet  
Lowest usable water formation: Dakota  
Depth to Bottom of usable water: 900 feet  
Surface pipe by Alternate: 1  2  250 feet  
Surface pipe to be set: none  
Conductor pipe if any required: unkn feet  
Ground surface elevation: feet MSL  
This Authorization Expires: 4-19-85  
Approved By: 10-19-84


I certify that we will comply with K.S.A. 55-101, et seq., plus eventually plugging hole to K.C.C. specifications.

Date: Signature of Operator or Agent: Paul A. Montoia Title: Geologist  
MHC/KOHE 10/19/84 Form C-1 4/84

Must be filed with the K.C.C. five (5) days prior to commencing well  
 This card void if drilling not started within six (6) months of date received by K.C.C.

**Important procedures to follow :**

**A Regular Section of Land**  
**1 Mile = 5,280 Ft.**

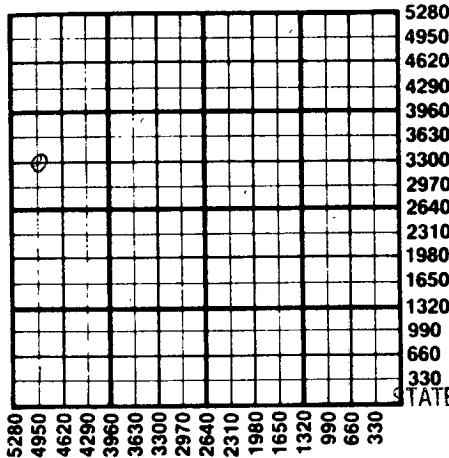

1. Notify District office before setting surface casing.
2. Set surface casing by circulating cement to the top.
3. File completion forms ACO-1 with K.C.C. within 90 days of well completion, following instructions on ACO-1, side 1, and including copies of wireline logs.
4. Notify District office 48 hours prior to old well workover or re-entry.
5. Prior to plugging, prepare a plugging plan, then obtain agreement from the appropriate district office for an approved plugging plan.
6. Submit plugging report (CP-4) to K.C.C. after plugging is completed.
7. Obtain an approved injection docket number before disposing of salt water.
8. Notify K.C.C. within 10 days when injection commences or terminates.

9. If an alternate 2 completion, cement in the production pipe from below any usable water to surface within 120 days of spud date.

CONSERVATION DIVISION  
 Wichita, Kansas

RECEIVED  
 10-19-1984  
 OCT 19 1984  
 State Corporation Commission of Kansas  
 Conservation Division  
 200 Colorado Derby Building  
 Wichita, Kansas 67202  
 (316) 263-3238