

CARD MUST BE TYPED

State of Kansas  
**NOTICE OF INTENTION TO DRILL**  
(see rules on reverse side)

CARD MUST BE SIGNED

Starting Date: ..... 11 ..... 28 ..... 85 .....  
month day year

API Number 15- 195-21,817-00-80

OPERATOR: License # ..... 8925 .....

NE NE NW ..... Sec .18 . Twp .12 . S, Rge . 21  
(location)  East  West

Name Liberty Operations and Completions, Inc.

Address ..... 308 West Mill .....

City/State/Zip Plainville, KS 67663

Contact Person David L. Comeau

Phone ..... (913) 434-4686 .....

4950 ..... Ft North from Southeast Corner of Section  
2970 ..... Ft West from Southeast Corner of Section  
(Note: Locate well on Section Plat on reverse side)

CONTRACTOR: License # ..... 5665 .....

Name Pioneer Drilling Co., Inc.

City/State Plainville, Kansas

Nearest lease or unit boundary line ..... 330 ..... feet.  
County Trego  
Lease Name Windholz Well# 1

Well Drilled For: Well Class: Type Equipment:

- Oil  Swd  Infield  Mud Rotary
- Gas  Inj  Pool Ext.  Air Rotary
- OWWO  Expl  Wildcat  Cable

Domestic well within 330 feet :  yes  no  
Municipal well within one mile :  yes  no

If OWWO: old well info as follows:

Operator .....

Well Name .....

Comp Date ..... Old Total Depth .....

Projected Total Depth ..... 4050 ..... feet

Projected Formation at TD ..... Arbuckle .....

Expected Producing Formations Lansing, Arbuckle .....

Depth to Bottom of fresh water ..... 100 ..... feet

Lowest usable water formation ..... Dakota .....

Depth to Bottom of usable water ..... ~~900~~ 1000 ..... feet

Surface pipe by Alternate : 1  2

Surface pipe to be set ..... 220 ..... feet

Conductor pipe if any required ..... N/A .....

Ground surface elevation ..... feet MSL.

This Authorization Expires ..... 5-13-86 .....

Approved By ..... 11-13-85 .....

*[Handwritten Signature]*

I certify that we will comply with K.S.A. 55-101, et seq., plus eventually plugging hole to K.C.C. specifications.

Date 11-11-85 Signature of Operator or Agent

*[Handwritten Signature]*

Title Vice Pres.

Must be filed with the K.C.C. five (5) days prior to commencing well  
 This card void if drilling not started within six (6) months of date received by K.C.C.


RECEIVED  
 STATE CORPORATION COMMISSION  
 11-13-85  
 NOV 13 1985

Important procedures to follow:

A Regular Section of Land  
 1 Mile = 5,280 Ft.

CONSERVATION DIVISION  
 Wichita, Kansas

1. Notify District office before setting surface casing.
2. Set surface casing by circulating cement to the top.
3. File completion forms ACO-1 with K.C.C. within 90 days of well completion, following instructions on ACO-1, side 1, and including copies of wireline logs.
4. Notify District office 48 hours prior to old well workover or re-entry.
5. Prior to plugging, prepare a plugging plan, then obtain agreement from the appropriate district office for an approved plugging plan.
6. Submit plugging report (CP-4) to K.C.C. after plugging is completed.
7. Obtain an approved injection docket number before disposing of salt water.
8. Notify K.C.C. within 10 days when injection commences or terminates.
9. If an alternate 2 completion, cement in the production pipe from below any usable water to surface within 120 days of spud date.

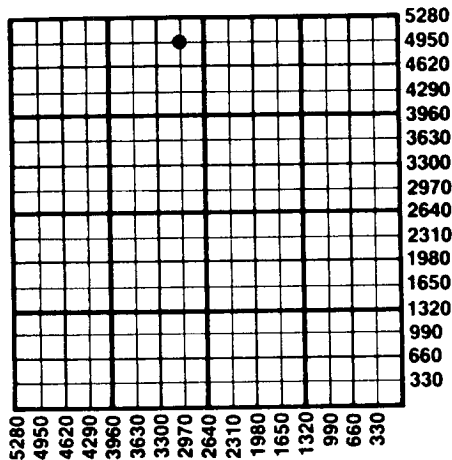

State Corporation Commission of Kansas  
 Conservation Division  
 200 Colorado Derby Building  
 Wichita, Kansas 67202  
 (316) 263-3238