

Exp. 2-7-85  
CARD MUST BE TYPED

10-CORRECT SPOT LOCATION  
State of Kansas  
**NOTICE OF INTENTION TO DRILL**

**CORRECTION**  
CARD MUST BE SIGNED

(see rules on reverse side)

15-163-22456-00-00

892 ✓

Starting Date: August 10 1984  
month day year

API Number 15-163-22,458

OPERATOR: License # 5457  
Name Monsanto Oil Company  
Address 3030 Northwest Expressway, Suite 1203  
City/State/Zip Oklahoma City, Oklahoma 73112  
Contact Person Robert J. Slaby  
Phone (405) 947-2361

\* NW SE SW Sec 28 Twp 10 S Rge 20  
(location)  East  West

990 Ft North from Southeast Corner of Section  
3630 Ft West from Southeast Corner of Section  
(Note: Locate well on Section Plat on reverse side)

CONTRACTOR: License # Pending  
Name  
City/State

Nearest lease or unit boundary line 990 feet.  
County Rooks  
Lease Name Tribble Well# 9

Well Drilled For: Well Class: Type Equipment:  
 Oil  Swd  Infield  Mud Rotary  
 Gas  Inj  Pool Ext.  Air Rotary  
 OWWO  Expl  Wildcat  Cable

Domestic well within 330 feet:  yes  no  
Municipal well within one mile:  yes  no

If OWWO: old well info as follows:  
Operator N/A  
Well Name  
Comp Date Old Total Depth  
Projected Total Depth 4000' feet  
Projected Formation at TD Arbuckle  
Expected Producing Formations Arbuckle/Lansing-KC

Depth to Bottom of fresh water 260 feet  
Lowest usable water formation Dakota  
Depth to Bottom of usable water 900 feet  
Surface pipe by Alternate: 1  2   
Surface pipe to be set 300 feet  
Conductor pipe if any required N/A feet  
Ground surface elevation 2160 feet MSL  
This Authorization Expires 2/7/85  
Approved By 8-7-84

I certify that we will comply with K.S.A. 55-101, et seq., plus eventually plugging hole to K.C.C. specifications.


Date 8-8-84 Signature of Operator or Agent Paul Hansen Title Regional Production Manager

**Must be filed with the K.C.C. five (5) days prior to commencing well  
This card void if drilling not started within six (6) months of date received by K.C.C.**

**Important procedures to follow :**

**A Regular Section of Land  
1 Mile = 5,280 Ft.**

1. Notify District office before setting surface casing.
  2. Set surface casing by circulating cement to the top.
  3. File completion forms ACO-1 with K.C.C. within 90 days of well completion, following instructions on ACO-1, side 1, and including copies of wireline logs.
  4. Notify District office 48 hours prior to old well workover or re-entry.
  5. Prior to plugging, prepare a plugging plan, then obtain agreement from the appropriate district office for an approved plugging plan.
  6. Submit plugging report (CP-4) to K.C.C. after plugging is completed.
  7. Obtain an approved injection docket number before disposing of salt water.
8. Notify K.C.C. within 10 days when injection commences or terminates.
9. Alternate 2 completion, cement in the production pipe from below any usable water to surface within 120 days of spud date.

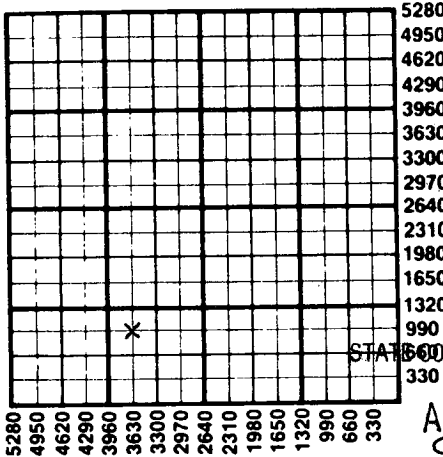

RECEIVED  
STATE CORPORATION COMMISSION

AUG 09 1984  
8-9-1984  
CONSERVATION DIVISION  
Wichita, Kansas

State Corporation Commission of Kansas  
Conservation Division  
200 Colorado Derby Building  
Wichita, Kansas 67202  
(316) 263-3238