


STATE OF KANSAS
STATE CORPORATION COMMISSION

Give All Information Completely
Make Required Affidavit
Mail or Deliver Report to:
Conservation Division
State Corporation Commission
212 North Market, Insurance Bldg.
Wichita, Kansas

15-051-00632-00-00
WELL PLUGGING RECORD

Ellis County, Sec. 31 Twp. 12 Rge. 17 (E) W (W)

Location as "NE/CNW/SW" or footage from lines SW SW SW
Lease Owner Leo J. Dreiling Oil Co.
Lease Name Staab Well No. 1
Office Address Victoria, Ks.
Character of Well (completed as Oil, Gas or Dry Hole) Oil
Date well completed _____ 19____
Application for plugging filed April 9 19 59
Application for plugging approved April 15 19 59
Plugging commenced April 13 19 59
Plugging completed April 14 19 59
Reason for abandonment of well or producing formation Depletion of oil

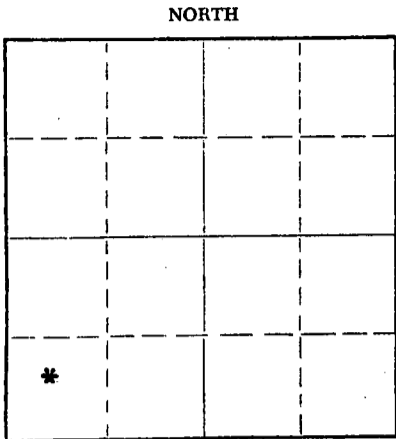

Locate well correctly on above Section Plat

If a producing well is abandoned, date of last production _____ 19____
Was permission obtained from the Conservation Division or its agents before plugging was commenced? Yes

Name of Conservation Agent who supervised plugging of this well Eldon Petty
Producing formation _____ Depth to top _____ Bottom _____ Total Depth of Well 3601' Feet
Show depth and thickness of all water, oil and gas formations.

OIL, GAS OR WATER RECORDS

CASING RECORD

FORMATION	CONTENT	FROM	TO	SIZE	PUT IN	PULLED OUT
				8 5/8	183'	none
				5 1/2	3600'	392'

Describe in detail the manner in which the well was plugged, indicating where the mud fluid was placed and the method or methods used in introducing it into the hole. If cement or other plugs were used, state the character of same and depth placed, from _____ feet to _____ feet for each plug set.

Plugged back with sand from 3601' to 3420'. Mixed and dumped 4 sx. cement from 3420' to 3388'. Pull 5 1/2. Mudded to 400'. Set 10' rock bridge from 400' to 390'. Mixed and dumped 20 sx. cement from 390' to 330'. Mudded from 330' to 35'. ~~Mixed and dumped~~ Set 5' rock bridge from 35' to 30'. Mixed and dumped 10 sx. cement from 30' to base cellar.

(If additional description is necessary, use BACK of this sheet)

Name of Plugging Contractor Ace Pipe Pulling Co.
Address Box 304 Great Bend, Ks.

STATE OF Kansas, COUNTY OF Russell, ss.
H. Howard McCoy (employee of owner) or (owner/operator) of the above-described well, being first duly sworn on oath, says: That I have knowledge of the facts, statements, and matters herein contained and the log of the above-described well as filed and that the same are true and correct. So help me God.

(Signature) Howard McCoy
316 Main Street, Russell, Kansas
(Address)

SUBSCRIBED AND SWORN to before me this 2nd day of May, 19 59

Jessie Lee Dumas
Notary Public.

My commission expires July, 18, 1961

PLUGGING
FILE SEC. 31 T. 12 R. 17
BOOK PAGE 29 LINE 3

WELL LOG
 15-051-00632-00-00
 GRAHAM MESSMAN RINEHART OIL CO.

Described as your STAAB #1 Well, located in
 Ellis County, Kansas.
 SW-SW-SW-31-12-17

FORMATION	FROM	TO
Shale & shells	0	183
Shale	183	220
Shale	220	735
Shale, shells & sand	735	1250
Shale & shells	1250	1307
Anhydrite	1307	1348
Shale	1348	1469
Shale & shells	1469	1720
Shale & Lime	1720	1992
Lime & shale	1992	2135
Shale & shells	2135	2245
Lime	2245	2255
Shale & lime	2255	2450
Lime & shale	2450	2540
Shale & shells	2540	3112
Shale	3112	3119
Lime	3119	3143
Lime & shale	3143	3198
Lime	3198	3243
Lime & shale	3243	3303
Lime & shale	3303	3412
Lime	3412	3608
Total Depth	3608	

I, the undersigned, being first duly sworn upon oath, state that this well record is true, correct and complete according to the records of this office and to the best of my knowledge and belief.


 G. Frederick

Subscribed and sworn to before me this 22nd day of August, 1951.


 Notary Public

My Commission Expires:
 October 14, 1953.

GMR
 File Copy

RECEIVED
 STATE CORPORATION COMMISSION
 4-10-1959
 APR 10 1959
 CONSERVATION DIV.
 Wichita, Kansas

PLUGGING
 FILE SEC. 31 T. 12 R. 17w
 BOOK PAGE 29 LINE 3