


15-163-02170-000

STATE OF KANSAS
STATE CORPORATION COMMISSION

Form CP-1

Give All Information Completely
Make Required Affidavit
Mail or Deliver Report to:
Conservation Division
State Corporation Commission
P. O. Box 17027
Wichita, Kansas 67217
NORTH

WELL PLUGGING RECORD

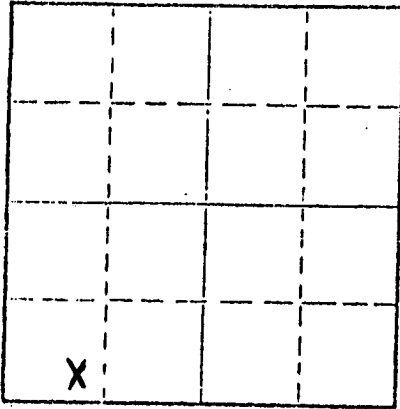

Locate well correctly on above Section Plat

Rooks County, Sec 15 Twp 10S Rge 20 (E) (W)
Location as "NE/CNWSW" or footage from lines 990' FWL and 330' FSL
Lease Owner Champlin Petroleum Company
Lease Name Marcotte Well No. 5
Office Address 6441 N.W. Grand Blvd., Suite 300 OKC, OK 73116
Character of Well (completed as Oil, Gas or Dry Hole) Saltwater disposal well
Date well completed 9-10 19 47
Application for plugging filed 3-24 19 82
Application for plugging approved 3-30 19 82
Plugging commenced 6-03 19 82
Plugging completed 6-04 19 82
Reason for abandonment of well or producing formation Inadequate disposal capacity

If a producing well is abandoned, date of last production N.A. 19
Was permission obtained from the Conservation Division or its agents before plugging was commenced? Yes

Name of Conservation Agent who supervised plugging of this well Mr. Dennis Hamel
Producing formation Lower Arbuckle & Basil Sand Depth to top 4050 Bottom 4150 Total Depth of Well 4198 Feet
Show depth and thickness of all water, oil and gas formations.

OIL, GAS OR WATER RECORDS

CASING RECORD

FORMATION	CONTENT	FROM	TO	SIZE	PUT IN	PULLED OUT
				10 3/4	160	0
				7"	4168	0

Describe in detail the manner in which the well was plugged, indicating where the mud fluid was placed and the method or methods used in introducing it into the hole. If cement or other plugs were used, state the character of same and depth placed, from feet to feet for each plug set.

Hook up Halliburton Cement Co. - Mix and pump 6 sx cotton seed hulls followed by 100 sx 50-50 Poz-Mix w/6% Gel and 1 1/2" Flo-Seal per sx cement and 45 sx cotton seed hulls mixed in cement. Pump 40 sx Gel followed by 350 sx 50-50 Poz-Mix w/6% Gel and 1 1/2" Flo-Seal per sack of cement. Well filled and cement came up in the cellar. Did not pressure on cement. Let set over night. Cement settled 160 over night - filled hole with 10 sx pre-mixed cement. Cap well w/2 sx dry cement. Cut casing off 4 ft. below ground level. Well P & A.

RECEIVED
STATE CORPORATION COMMISSION
JUN 16 1982
6-16-82
CONSERVATION DIVISION
Wichita, Kansas

Name of Plugging Contractor Not applicable
Address

STATE OF Oklahoma COUNTY OF Oklahoma ss.
J. W. Meyers (employee of owner) or (OWNER REPRESENTATIVE) of the above-described

well, being first duly sworn on oath, says: That I have knowledge of the facts, statements, and matters herein contained and the log of the above-described well as filed and that the same are true and correct. So help me God.

(Signature) J. W. Meyers
Champlin Petroleum Company
6441 N.W. Grand Blvd., Suite 300, OKC, OK 73116
(Address)

SUBSCRIBED AND SWORN TO before me this 15th day of June, 19 82

My commission expires 10-8-83
Notary Public.