


Give All Information Completely
Make Required Affidavit
Mail or Deliver Report to:
Conservation Division
State Corporation Commission
211 No. Broadway
Wichita, Kansas

WELL PLUGGING RECORD

Rooks County. Sec. 15 Twp. 10 Rge. 20W (E) (W)

Location as "NE/CNW/SW" or footage from lines NW SW NE
Lease Owner Champlin Petroleum Company
Lease Name Brueggeman Well No. 8
Office Address P. O. Box 308, Ellinwood, Kansas
Character of Well (completed as Oil, Gas or Dry Hole) D & A
Date well completed July 6 1967
Application for plugging filed July 6 1967
Application for plugging approved July 6 1967
Plugging commenced July 6 1967
Plugging completed July 6 1967
Reason for abandonment of well or producing formation D & A

NORTH

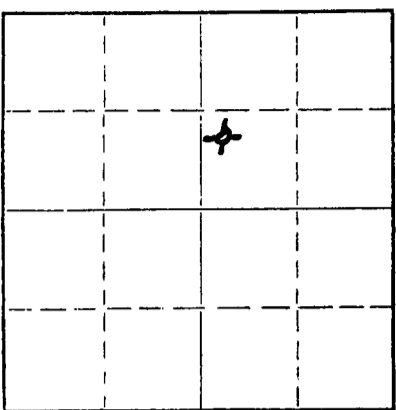

Locate well correctly on above
Section Plat

If a producing well is abandoned, date of last production _____ 19____
Was permission obtained from the Conservation Division or its agents before plugging was commenced? Yes

Name of Conservation Agent who supervised plugging of this well Leo F. Massey
Producing formation _____ Depth to top _____ Bottom _____ Total Depth of Well 3835 Feet
Show depth and thickness of all water, oil and gas formations.

OIL, GAS OR WATER RECORDS

CASING RECORD

FORMATION	CONTENT	FROM	TO	SIZE	PUT IN	PULLED OUT
				8 5/8"	972.16'	- 0 -

Describe in detail the manner in which the well was plugged, indicating where the mud fluid was placed and the method or methods used in introducing it into the hole. If cement or other plugs were used, state the character of same and depth placed, from _____ feet to _____ feet for each plug set.

Spot 20 sx cement @ 950'.
Mud to 300'. 1/3 sx hulls.
Plug 20 sx cement. Mud to
40'. 1/2 sx hulls. Cement
to base of cellar. 2 sx in
Rathole.

RECEIVED
STATE CORPORATION COMMISSION
7-13-67
JUL 13 1967

CONSERVATION DIVISION
Wichita, Kansas

(If additional description is necessary, use BACK of this sheet)

Name of Plugging Contractor Red Tiger Drilling Company
Address P. O. Box 173, Russell, Kansas

STATE OF KANSAS COUNTY OF SEDGWICK, ss.
Maxine V. Starr (employee of owner) or (~~owner~~) of the above-described well, being first duly sworn on oath, says: That I have knowledge of the facts, statements, and matters herein contained and the log of the above-described well as filed and that the same are true and correct. So help me God.

(Signature) Maxine V. Starr
1720 Wichita Plaza, Wichita, Kansas
(Address)

SUBSCRIBED AND SWORN to before me this 7th day of July, 1967

My commission expires 3-22-71
Betty M. Maloney Notary Public.



DRILLERS LOG

Brueggeman No. 8

CASING RECORD: 8 5/8" @ 972.16' w/425 sx cement
 COMPANY: Champlin Petroleum Co.
 CONTRACTOR: Red Tiger Drilling Co.
 COMMENCED: June 27, 1967
 COMPLETED: July 6, 1967

DESCRIPTION:
 NW SW NE
 15-108-20W
 Rooks County, Ks.

TOTAL DEPTH: 3835'

ELEVATION:

<u>FORMATION</u>	<u>FROM</u>	<u>TO</u>	<u>REMARKS</u>
Surface Soil, Sand	0	30	
Shale & Shells	30	1090	
Shale & Shells & Sand Stringers	1090	1140	
Dakota Sand	1140	1390	
Red Bed	1390	1664	
Anhydrite	1664	1703	
Shale & Shells	1703	1710	
Shale	1710	1955	
Shale & Lime	1955	3113	
Lime	3113	3720	
Lime & Shale	3720	3787	
Shale	3787	3790	
Arbuckle	3790	3835	

RECEIVED
 STATE CORPORATION COMMISSION
 JUL 18 1967
 CONSERVATION DIVISION
 Wichita, Kansas

I certify that this is a true and correct copy of the above log to the best of my knowledge.

RED TIGER DRILLING COMPANY

Maxine V. Starr
 Maxine V. Starr

Subscribed and sworn to before me this 7th day of July, 1967.

Betty M. Maloney
 Notary Public

