


15-163-03332-0000

STATE OF KANSAS
STATE CORPORATION COMMISSION

WELL PLUGGING RECORD

Give All Information Completely
Make Required Affidavit
Mail or Deliver Report to:
Conservation Division
State Corporation Commission
800 Biting Building
Wichita, Kansas

Rooks County. Sec. 16 Twp. 10S Rge. 20 (W)
Location as "NE/CNW 1/4 SW 1/4" or footage from lines NW 1/4 NE 1/4 NW 1/4
Lease Owner Heathman Drilling Co., Inc., et al
Lease Name WILLIAMS Well No. 2
Office Address 509 Orpheum Building, Wichita, Kansas
Character of Well (completed as Oil, Gas or Dry Hole) dry hole
Date well completed 7-21-1950
Application for plugging filed 7-21-1950
Application for plugging approved 7-21-1950
Plugging commenced 7-21-1950
Plugging completed 7-21-1950
Reason for abandonment of well or producing formation -----

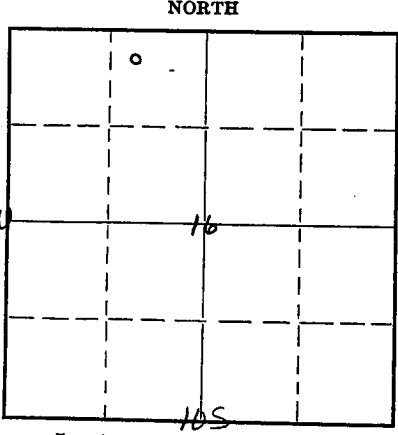

Locate well correctly on above Section Plat

If a producing well is abandoned, date of last production ----- 19
Was permission obtained from the Conservation Division or its agents before plugging was commenced? yes

Name of Conservation Agent who supervised plugging of this well Eldon Petty, Hays, Kansas
Producing formation none Depth to top ----- Bottom ----- Total Depth of Well 384.3 Feet
Show depth and thickness of all water, oil and gas formations.

OIL, GAS OR WATER RECORDS

CASING RECORD

Formation	Content	From	To	Size	Put In	Pulled Out
none	---	---	---	8-5/8" w/80 sacks and 1 sack	111' cement Cal. Chloride	none

Describe in detail the manner in which the well was plugged, indicating where the mud fluid was placed and the method or methods used in introducing it into the hole. If cement or other plugs were used, state the character of same and depth placed, from ----- feet to ----- feet for each plug set.

Plugged hole @ 100' w/10 sacks cement, surface pipe cut off 3' below level of ground.

07-28-50

(If additional description is necessary, use BACK of this sheet)

Correspondence regarding this well should be addressed to Heathman Drilling Co., Inc.
Address 509 Orpheum Building, Wichita, Kansas

STATE OF Kansas, COUNTY OF Sedgwick, ss.
H. D. Shreve (employee of owner) of the above-described well,

being first duly sworn on oath, says: That I have knowledge of the facts, statements, and matters herein contained and the log of the above-described well as filed and that the same are true and correct. So help me God. HEATHMAN DRILLING CO., INC.

(Signature) BY: H. D. Shreve

509 Orpheum Building, Wichita, Kansas
(Address)

SUBSCRIBED AND SWORN to before me this 27th day of July, 1950

My commission expires June 28, 1952.

D. Marjorie Mast
Notary Public.

PLUGGING
FILE SEC 16 T 10 R 204
BOOK PAGE 18 LINE 21

WILLIAMS # 2 WELL

Location:	NW/4 NE/4 NW/4 Sec. 16-10N-20W Rooks County, Kansas	Date Spudded: 7-11-50
Operator:	Heathman Drilling Co., Inc.	Date Completed: 7-21-50
Contractor:	Heathman Drilling Co., Inc.	Elevation: 2241 DF; 2243 KB
Surface casing:	5 jts. 8-5/8" cemented @ 111' w/ 80 sacks cement and 1 C.C.	Total Depth: 3843'
Oil String:	None run - Dry and abandoned - 7-21-50	

T O P S KB

Anhydrite	1725 (+518)
Topeka	3287 (-1044)
Heebner	3494 (-1251)
Lansing-K.C.	3536 (-1293)
Base Kansas City	3760 (-1517)
Conglomerate	3801 (-1558)
Total Depth in Congl.	3843' (-1600)

L O G

(Figures indicate bottom of formation.)

Shale and sand	0 to 15
Sand shale	112
Sand shale	650
Shale and stone sand	1130
Sand	1243
Sand	1420
Shale and shells	1700
Shale - red bed	1725
Anhydrite	1759
Shale - shells	2290
Shale lime	2944
Shale	3196
Shale and lime	3284
Lime	3456
Lime and shale	3523
Lime	3775
Lime and Conglomerate	3816
Lime and shale	3843
Total Depth	3843'

RECEIVED
 Conf. State D.V.
 JUL 28 1950
 STATE CORPORATION
 COMMISSION
 KANSAS

The undersigned, H. D. Shreve of the Heathman Drilling Co., Inc., hereby certifies that the above is a true and correct log of the formations encountered in drilling the Williams #2 well as shown on the daily drilling reports.

H. D. Shreve
 H. D. Shreve

Subscribed and sworn to before me
 this 27th day of July 1950.

H. D. Marjorie Mott
 Notary Public

By commission expires: June 28, 1952.

PLUGGING
 FILE SEC 16 T 10 R 20W
 BOOK PAGE 18 LINE 31