

15-163-20365-0000

Give All Information Completely
Make Required Affidavit
Mail or Deliver Report to:
Conservation Division
State Corporation Commission
212 No. Market
Wichita, Kansas


WELL PLUGGING RECORD

ROOKS

County. Sec. 16 Twp. 10S Rge. 20W (E) (W)

Location as "NE/CNWxSWx" or footage from lines NW NW NE
Lease Owner DANE G. HANSEN TRUST
Lease Name WILLIAMS Well No. 6
Office Address LOGAN, KANSAS 67646
Character of Well (completed as Oil, Gas or Dry Hole) DRY HOLE
Date well completed APRIL 29 19 71
Application for plugging filed APRIL 29 19 71
Application for plugging approved APRIL 29 19 71
Plugging commenced APRIL 29 19 71
Plugging completed APRIL 29 19 71
Reason for abandonment of well or producing formation TOO LOW STRUCTURALLY

NORTH

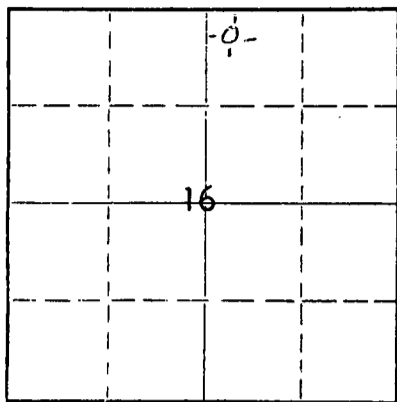

Locate well correctly on above Section Plat

If a producing well is abandoned, date of last production _____ 19____
Was permission obtained from the Conservation Division or its agents before plugging was commenced? YES

Name of Conservation Agent who supervised plugging of this well LEO F. MASSEY, HAYS, KANSAS
Producing formation _____ Depth to top _____ Bottom _____ Total Depth of Well 3815 Feet
Show depth and thickness of all water, oil and gas formations.

OIL, GAS OR WATER RECORDS

CASING RECORD

FORMATION	CONTENT	FROM	TO	SIZE	PUT IN	PULLED OUT
				8 5/8"	221.76'	None

Describe in detail the manner in which the well was plugged, indicating where the mud fluid was placed and the method or methods used in introducing it into the hole. If cement or other plugs were used, state the character of same and depth placed, from _____ feet to _____ feet for each plug set.

FILLED WITH HEAVY MUD TO 720'. SET PLUG.
PUT IN 70 SACKS CEMENT. FILLED WITH HEAVY MUD TO 210'. SET PLUG. PUT IN 30 SACKS CEMENT. FILLED WITH HEAVY MUD TO 40'. SET PLUG. FILLED TO TOP WITH 10 SACKS CEMENT.

RECEIVED
STATE CORPORATION COMMISSION
MAY 12 1971
CONSERVATION DIVISION
Wichita, Kansas

Name of Plugging Contractor C-G DRILLING CO.
Address 1107 UNION NATIONAL BUILDING, WICHITA, KANSAS 67202


STATE OF KANSAS, COUNTY OF SEDGWICK, ss.
G. F. GALLOWAY (employee of owner) or (owner or operator) of the above-described

well, being first duly sworn on oath, says: That I have knowledge of the facts, statements, and matters herein contained and the log of the above-described well as filed and that the same are true and correct. So help me God.

(Signature) G. F. Galloway
1107 Union National Bldg.
(Address)

Subscribed and sworn to before me this 6th day of May, 19 71
My Commission expires December 7, 1971

Phyllis Buchanan
Phyllis Buchanan
Notary Public.

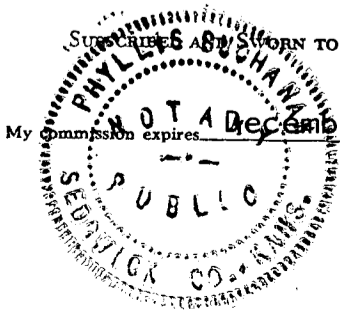

15-163-20365-0000

WELL LOG

OPERATOR: DANE G. HANSEN TRUST

WELL NAME: WILLIAMS #6 LOCATION: NW NW NE

COUNTY: ROOKS STATE: KANSAS

WELL COMMENCED: APRIL 22, 1971 WELL COMPLETED: APRIL 29, 1971

ELEVATION: 2215 KB TOTAL DEPTH: 3815'

PRODUCTION: DRY & ABANDONED RIG NO: #1

CASING - 8-5/8": RAN 11 JTS (221.76') 8 5/8" OD SURFACE CASING 28#

5-1/2":

ALL MEASUREMENTS TAKEN FROM THE TOP OF ROTARY BUSHING:

FROM	TO	FORMATION	DEVIATION FROM VERTICAL	REMARKS:
0	890	SHALE		
890	1070	SAND	3/4° 1038'	
1070	1160	SHALE		
1160	1360	SAND		
1360	1688	RED BED	1/2° 1525'	
1688	1727	ANHYDRITE		
1727	1840	SHALE & SHELLS		
1840	2150	SHALE		
2150	3506	SHALE & LIME	1/4° 2200'	
3506	3815	LIME		DST #1 3791'-3797'
3815		RTD		

RECEIVED
STATE CORPORATION COMMISSION
MAY 12 1971
CONSERVATION DIVISION
Wichita, Kansas

STATE OF KANSAS)
COUNTY OF SEDGWICK) SS:

The undersigned hereby certifies that to the best of his knowledge and belief, the above facts are true and correct.

C-G DRILLING CO.

By G. F. Galloway

SUBSCRIBED AND SWORN TO, BEFORE ME, This 6th day of May, 1971.

MY COMM. EXP. DEC. 7, 1971

Phyllis Buchanan
PHYLLIS BUCHANAN - NOTARY PUBLIC

