


15-163-03331-0000

STATE OF KANSAS
STATE CORPORATION COMMISSION

WELL PLUGGING RECORD

Give All Information Completely
Make Required Affidavit
Mail or Deliver Report to:
Conservation Division
State Corporation Commission
800 Bitting Building
Wichita, Kansas

NORTH

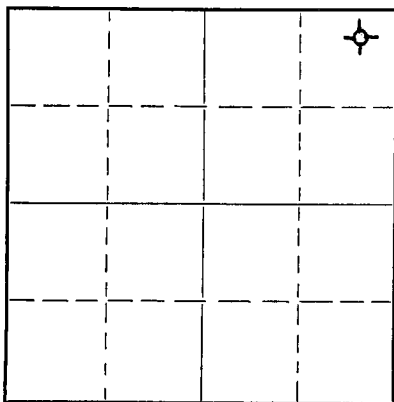

Locate well correctly on above
Section Plat

Rooks County. Sec. 16 Twp. 10 Rge. 20 (E) W (W)
Location as "NE/CNW 1/4 SW 1/4" or footage from lines NE. NE. NE.
Lease Owner D. G. Hansen
Lease Name Williams Well No. 1
Office Address Logan, Kansas
Character of Well (completed as Oil, Gas or Dry Hole) dry hole
Date well completed August 28 19 50
Application for plugging filed August 28 19 50
Application for plugging approved " 19 50
Plugging commenced August 28 19 50
Plugging completed August 28 19 50
Reason for abandonment of well or producing formation Too low structurally
Did not get Arbuckle.
If a producing well is abandoned, date of last production 19
Was permission obtained from the Conservation Division or its agents before plugging was commenced? yes

Name of Conservation Agent who supervised plugging of this well Mr. Stull, Hays, Kansas
Producing formation Depth to top Bottom Total Depth of Well Feet
Show depth and thickness of all water, oil and gas formations.

OIL, GAS OR WATER RECORDS

CASING RECORD

Formation	Content	From	To	Size	Put In	Pulled Out
				8-5/8" (28#)	250'	

Describe in detail the manner in which the well was plugged, indicating where the mud fluid was placed and the method or methods used in introducing it into the hole. If cement or other plugs were used, state the character of same and depth placed, from feet to feet for each plug set.

Filled with drilling Mud to 252'. Drove plug to 250'. Put in 15 sacks cement then pumped full of mud 25' from top of hole. Drove plug down to 25' then filled to top with 10 sacks of cement.

08-31-50

(If additional description is necessary, use BACK of this sheet)

Correspondence regarding this well should be addressed to D. G. Hansen
Address Logan, Kansas

STATE OF KANSAS, COUNTY OF SEDGWICK, SS.
R. A. COOK (employee of owner) or XXXXXXXXXXXX of the above-described well,

being first duly sworn on oath, says: That I have knowledge of the facts, statements, and matters herein contained and the log of the above-described well as filed and that the same are true and correct. So help me God.

(Signature) R A Cook

206 Union National Bank Bldg.

(Address)

SUBSCRIBED AND SWORN to before me this 30 day of August, 19 50

Almeda Lowe

Notary Public.

My commission expires August 11, 1954

22-7377-s 4-49-10M

PLUGGING
FILE SEC Met 10 R 200
BOOK PAGE 24 LINE 44

15-163-03331-0000

CONTRACTOR 'S WELL LOG

Operator D. G. Hansen Farm Name Williams #1

Location NE NE NE Sec. 16-10-20W

Pool Name Marcotte County Rooks State Kansas

Commencement Date August 18, 1950 Completion Date August 28, 1950

LOG OF WELL

Elevation 2148 RB

All measurements from the top of rotary bushing.

DEPTH	FORMATION	DEVIATION FROM VERTICAL	REMARKS:
FROM 0 TO 250			
250 TO 600	Shale		
600 TO 790	Shale-Sand		
790 TO 915	Dakota Sand		
915 TO 1065	Shale-Shells		
1065 TO 1255	Shale-Sand		
1255 TO 1275	Sand		
1275 TO 1385	Sand		
1385 TO 1585	Shale Sand-RedBed	1500' -00	
1585 TO 1603	Shale-RedBed		
1603 TO 1640	Anhydrite		
1640 TO 1880	Shale-Shells		
1880 TO 2130	Shale-Shells		
2130 TO 2215	Shale-Shells		
2215 TO 2240	Lime (Broken)		
2240 TO 2420	Lime-Shale		
2420 TO 2515	Lime-Shale		
2515 TO 2625	Lime-Shale	2500' -00	
2625 TO 2765	Lime-Shale		
2765 TO 2865	Shale-Lime		
2865 TO 2990	Shale-Lime		
2990 TO 3150	Shale-Lime	3000' -00	
3150 TO 3270	Shale-Lime		
3270 TO 3310	Shale-Lime		
3310 TO 3360	Shale-Lime		
3360 TO 3410	Lime-Shale		
3410 TO 3460	Lime		
3460 TO 3505	Lime		
3505 TO 3555	Lime	3500' -00	
3555 TO 3605	Lime		
3605 TO 3645	Lime		
3645 TO 3715	Lime		
3715 TO 3752	Lime		

CASING LEFT IN HOLE AFTER COMPLETION

Ran 250' (8 Jts.) 8-5/8" OD Casing.

STATE OF KANSAS, COUNTY OF SEDGWICK)ss

The undersigned certifies that to the best of his knowledge and belief, the above facts are true and correct.

C-G DRILLING COMPANY, Inc.

By [Signature], President

Subscribed and sworn to before me this 30th day of August, 1950.

My commission expires: August 11, 1954.

[Signature]
Notary Public

PLUGGING
FILE SEC 16 T 10 R 20
BOOK PAGE 24 LINE 44