


15-163-00866-0000

STATE OF KANSAS  
STATE CORPORATION COMMISSION

Give All Information Completely  
Make Required Affidavit  
Mail or Deliver Report to:  
Conservation Division  
State Corporation Commission  
800 Bitting Building  
Wichita, Kansas

WELL PLUGGING RECORD

NORTH

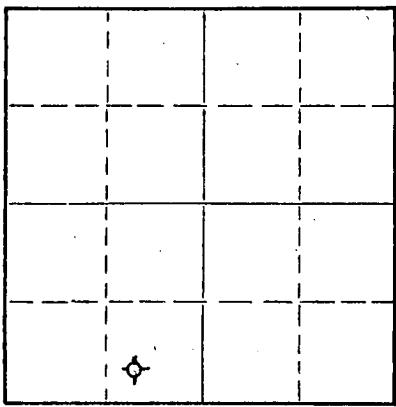

Locate well correctly on above  
Section Plat

Rooks County, Sec. 16 Twp. 10S Rge. 20 (E) W (W)

Location as "NE/CNW/SW" or footage from lines SW/4 SE/4 SW/4

Lease Owner D. G. Hansen

Lease Name Colby Well No. I

Office Address Logan, Kansas

Character of Well (completed as Oil, Gas or Dry Hole) dry hole

Date well completed June 12 19 55

Application for plugging filed June 12 19 55

Application for plugging approved June 12 19 55

Plugging commenced June 12 19 55

Plugging completed June 12 19 55

Reason for abandonment of well or producing formation Too low structurally.

If a producing well is abandoned, date of last production -- 19

Was permission obtained from the Conservation Division or its agents before plugging was commenced? Yes

Name of Conservation Agent who supervised plugging of this well Eldon Petty

Producing formation Depth to top Bottom Total Depth of Well Feet

Show depth and thickness of all water, oil and gas formations.

OIL, GAS OR WATER RECORDS

CASING RECORD

FORMATION	CONTENT	FROM	TO	SIZE	PUT IN	PULLED OUT
				8-5/8"	165.35'	none

Describe in detail the manner in which the well was plugged, indicating where the mud fluid was placed and the method or methods used in introducing it into the hole. If cement or other plugs were used, state the character of same and depth placed, from feet to feet for each plug set.

Filled hole with heavy mud to 164'. Set plug.  
Put in 1/2 sack hulls and 15 sacks of cement.  
Filled with heavy mud up to 40'. Set Plug.  
Filled to top with 1/2 sack hulls and 10 sacks cement.

(If additional description is necessary, use BACK of this sheet)

Name of Plugging Contractor C-G DRILLING CO.

Address 107 Rule Building, Wichita, Kansas

STATE OF KANSAS, COUNTY OF SEDGWICK, ss.


Jay H. Galloway (employee of owner) or (owner) of the above-described well, being first duly sworn on oath, says: That I have knowledge of the facts, statements, and matters herein contained and the log of the above-described well as filed and that the same are true and correct. So help me God.

(Signature) Jay H. Galloway  
107 Rule Bldg., Wichita, Kansas  
(Address)

Subscribed and sworn to before me this 17th day of June, 19 55

My Commission expires May 20, 1959

Wicky Jacobs Notary Public.

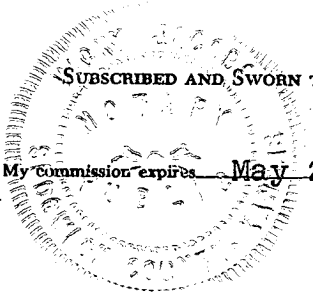

PLUGGING  
FILE SEC 16 T 10 R 210  
1955 JUN 26 TIME 26

RECEIVED  
STATE CORPORATION COMMISSION  
JUN 18 1955  
CONSERVATION DIVISION  
Wichita, Kansas

CONTRACTOR'S WELL LOG

OPERATOR D. G. HANSEN WELL NAME COLBY #1  
 LOCATION SW/4 SE/4 SW/4 Sec. 16-10S-20W  
 POOL NAME \_\_\_\_\_ COUNTY Rooks STATE Kansas  
 COMMENCEMENT DATE June 4, 1955 COMPLETION DATE June 12, 1955

LOG OF WELL

Elevation 2211 R.D.  
 All measurements from the top of rotary bushing.

FROM	TO	FORMATION	DEVIATION FROM VERTICAL	REMARKS:
0	165	Shale-Sand		
165	1280	Shale-Shells-Sand		
1280	1410	Sand		
1410	1682	Red Bed		
1682	1722	Anhydrite		
1722	1780	Shale		
1780	2210	Shale-Shells		
2210	2400	Lime-Shale		
2400	2525	Lime-Shale		
2525	2630	Lime-Shale	0° - 2500'	
2630	2890	Lime-Shale		
2890	2990	Lime-Shale		
2990	3130	Lime-Shale	0° - 3000'	
3130	3260	Lime-Shale		
3260	3360	Lime-Shale		
3360	3400	Lime-Shale		
3400	3450	Lime-Shale		
3450	3520	Lime-Shale	0° - 3500'	
3520	3575	Lime-Shale		
3575	3615	Lime-Shale		
3615	3669	Lime-Shale		
3669	3725	Lime-Shale	0° - 3750'	
3725	3762	Lime-Shale		
3762	3810	Lime-Shale		
3810	3880	Lime-Shale		

CASING LEFT IN HOLE AFTER COMPLETION

Set 165.35' (8 jts.) 8-5/8" OD Surface Casing with 130 sacks of cement.

STATE OF KANSAS, COUNTY OF SEDGWICK) ss.

The undersigned certifies that to the best of his knowledge and belief, the above facts are true and correct.

C-G DRILLING CO.

By Jay H. Galloway  
Jay H. Galloway

Subscribed and sworn to before me this 17th day of June, 1955.

My commission expires: May 20, 1959

Vicky Jacobs  
Notary Public



**PLUGGING**  
SEC 16 T 10 R 20W  
8264 Page 126 Line 26

RECEIVED  
STATE CORPORATION COMMISSION  
JUN 17 1955  
CONSERVATION DIVISION  
Wichita, Kansas