


STATE OF KANSAS
STATE CORPORATION COMMISSION

Give All Information Completely
Make Required Affidavit
Mail or Deliver Report to:
Conservation Division
State Corporation Commission
211 No. Broadway
Wichita, Kansas

WELL PLUGGING RECORD

NORTH

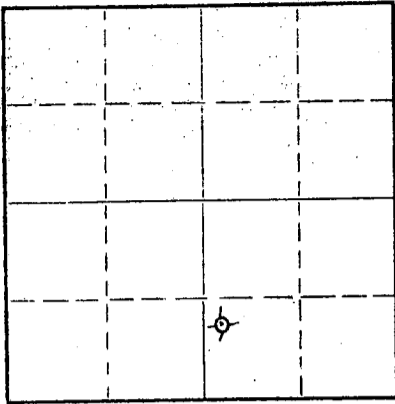

Locate well correctly on above
Section Plat

Rooks County. Sec. 16 Twp. 10 Rge. 20 (E) W (W)
Location as "NE/CNW/SW" or footage from lines NW SW SE
Lease Owner D. G. Hansen
Lease Name Cowgill Well No. 1
Office Address Logan, Kansas
Character of Well (completed as Oil, Gas or Dry Hole) Dry Hole
Date well completed January 7 19 56
Application for plugging filed January 7 19 56
Application for plugging approved January 7 19 56
Plugging commenced January 8 19 56
Plugging completed January 8 19 56
Reason for abandonment of well or producing formation Too low structurally

If a producing well is abandoned, date of last production _____ 19____
Was permission obtained from the Conservation Division or its agents before plugging was commenced? Yes

Name of Conservation Agent who supervised plugging of this well Eldon Petty, Hays, Kansas
Producing formation _____ Depth to top _____ Bottom _____ Total Depth of Well 3926 Feet
Show depth and thickness of all water, oil and gas formations.

OIL, GAS OR WATER RECORDS

CASING RECORD

FORMATION	CONTENT	FROM	TO	SIZE	PUT IN	PULLED OUT
				8-5/8"	153'	none

Describe in detail the manner in which the well was plugged, indicating where the mud fluid was placed and the method or methods used in introducing it into the hole. If cement or other plugs were used, state the character of same and depth placed, from _____ feet to _____ feet for each plug set.

Filled hole with heavy mud to 148'. Set plug. Put in 1/2 sack Hulls and 15 sacks cement. Filled with heavy mud to 40'. Set plug. Filled to top with 1/2 sack hulls and 10 sacks cement.

(If additional description is necessary, use BACK of this sheet)

Name of Plugging Contractor C-G Drilling Co.
Address 107 Rule Building, Wichita, Kansas


STATE OF Kansas, COUNTY OF Sedgwick, ss.
G. F. Galloway (employee of owner) or (owner or operator) of the above-described well, being first duly sworn on oath, says: That I have knowledge of the facts, statements, and matters herein contained and the log of the above-described well as filed and that the same are true and correct. So help me God.

(Signature) G. F. Galloway
107 Rule Bldg.
(Address)

SUBSCRIBED AND SWORN TO before me this 11th day of January, 1956

My commission expires May 20, 1959

Vicky Jacobs
Vicky Jacobs Notary Public.

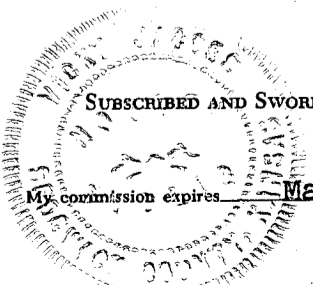

PLUGGING
FILE SEC 16 T 10 R 20W
BOOK PAGE 30 LINE 44

1-12-56
DIVISION
KANSAS

15-163-00990-0000

CONTRACTOR'S WELL LOG

OPERATOR- D. G. HANSEN WELL NAME COWGILL #1

LOCATION NW SW SE Sec. 16-10S-20W RIG NO. 2

COUNTY SEDGWICK STATE KANSAS

COMMENCEMENT DATE DECEMBER 8, 1955 COMPLETION DATE JANUARY 8, 1956

LOG OF WELL

Elevation 2219' rotary bushing.
All measurements taken from top of rotary bushing.

FROM	TO	FORMATION	DEVIATION FROM VERTICAL	REMARKS
0	120	Shale		
120	880	Shale		
880	940	Sand		
940	1025	Shale		
1025	1170	Shale		
1170	1430	Sand		
1430	1694	Red Bed		
1694	1725	Anhydrite		
1725	1733	Anhydrite		
1733	2185	Shale-Shells		
2185	2365	Lime-Shale		
2365	2525	Lime-Shale	0° - 2500'	
2525	2625	Lime-Shale		
2625	2820	Lime-Shale	0° - 2750'	
2820	2920	Lime-Shale		
2920	3030	Lime-Shale	0° - 3000'	
3030	3185	Lime-Shale		
3185	3280	Lime-Shale	0° - 3250'	
3280	3370	Lime-Shale		
3370	3425	Lime-Shale		
3425	3570	Lime-Shale	0° - 3500'	
3570	3619	Lime-Shale		
3619	3725	Lime-Shale		
3725	3800	Lime-Shale	0° - 3750'	
3800	3920	Lime-Shale		
3920	3926	Lime-Shale		
	3926	TD		

CASING LEFT IN HOLE AFTER COMPLETION

153' of 8-5/8" OD Surface Casing

STATE OF KANSAS, COUNTY OF SEDGWICK) SS.

The undersigned certified that to the best of his knowledge and belief, the above facts are true and correct.

C-G DRILLING CO.

By G. F. Galloway
G. F. Galloway

Subscribed and sworn to before me this 10th day of January, 1956.

My commission expires:
May 20, 1959.

Vicky Jacobs
Vicky Jacobs, Notary Public

PLUGGING
FILE SEC 16-10-20W
BOOK PAGE 30 LINE 44