


15-163-00663-0000

STATE OF KANSAS
STATE CORPORATION COMMISSION

WELL PLUGGING RECORD

Give All Information Completely
Make Required Affidavit
Mail or Deliver Report to:
Conservation Division
State Corporation Commission
800 Biting Building
Wichita, Kansas

Rocks _____ County. Sec. 21 Twp. 10 Rge. (E) 20 (W)
Location as "NE/CNW/SW" or footage from lines NW SE NW
Lease Owner The Derby oil Company
Lease Name Hinkhouse Well No. 2
Office Address Box 1030, Wichita, Kansas
Character of Well (completed as Oil, Gas or Dry Hole) Dry Hole
Date well completed June 30, 19 54
Application for plugging filed July 2, 19 54
Application for plugging approved July 6, 19 54
Plugging commenced August 16, 19 54
Plugging completed September 8, 19 54
Reason for abandonment of well or producing formation Dry Hole

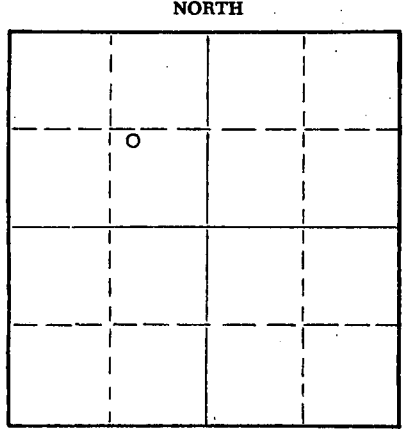

Locate well correctly on above Section Plat

If a producing well is abandoned, date of last production _____ 19 _____
Was permission obtained from the Conservation Division or its agents before plugging was commenced? Yes

Name of Conservation Agent who supervised plugging of this well Eldon Petty
Producing formation _____ Depth to top _____ Bottom _____ Total Depth of Well 3830 Feet
Show depth and thickness of all water, oil and gas formations.

OIL, GAS OR WATER RECORDS

CASING RECORD

FORMATION	CONTENT	FROM	TO	SIZE	PUT IN	PULLED OUT
				8 5/8	250	None
				5 1/2	3830	2119

Describe in detail the manner in which the well was plugged, indicating where the mud fluid was placed and the method or methods used in introducing it into the hole. If cement or other plugs were used, state the character of same and depth placed, from _____ feet to _____ feet for each plug set.

Filled back in the pipe to 3750'. Dumped 5 sacks of cement. Shot pipe off at 2119'. Pulled pipe and mudded hole to 240'. Set rock bridge and dumped 15 sacks of cement. Finished mudding hole and dumped 10 sacks of cement at top of surface.


(If additional description is necessary, use BACK of this sheet)
Name of Plugging Contractor Bert Self
Address Hutchinson, Kansas

STATE OF KANSAS, COUNTY OF SEDGWICK, ss.
Bill K. Henrichs (employee of owner) or (owner or operator) of the above-described well, being first duly sworn on oath, says: That I have knowledge of the facts, statements, and matters herein contained and the log of the above-described well as filed and that the same are true and correct. So help me God.

(Signature) Bill K. Henrichs
Box 1030, Wichita, Kansas
(Address)

SUBSCRIBED AND SWORN TO before me this 16th day of September, 19 54

My commission expires August 24, 1957
Notary Public.

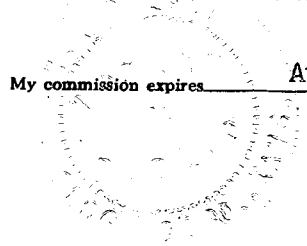

PLUGGING
FILE DEC 21 7 10 20W
BOOK PAGE 46 LINE 10

09-18-54
RECEIVED
STATE CORPORATION COMMISSION

DRILLERS' LOG

Co: The Derby Oil Company

C NW/4 SE/4 NW/4

Farm Name: Hinkhouse Well No. 2

Sec. 21, Twp. 10S, Rge. 20W,

Total Depth: 3830'

County: Reeks,
Kansas

Comm: 6-7-54 Comp: 6-17-54

Contractor: Glenn W. Peel

Elevation:

Casing: 8 5/8" 250' cem.
5 1/2" 3830' cem.

Production:

Figures below indicate bottoms of formations:

Surface soils and sands	0 -	252
Shale		1000
Sand		1150
Sand and shale		1420
Shale and shells		1660
Anhydrite		1700
Shale and shells		2275
Shale and Lime		2350
Lime		2655
Shale and Lime		2710
Lime		2835
Lime and shale		3270
Lime		3830
Total Depth		3830

This is to certify that the above information is to the best of our knowledge, true and correct.

GLENN W. PEEL

BY: *Glenn W. Peel*

SUBSCRIBED AND SWORN to before me this 19th day of June, 1954.

My commission expires: June 4, 1955

Marion M. Herbert
Notary Public

GEOLOGICAL INFORMATION

- HEEBNER 3473 -1262
- TORONTO 3495 -1284
- LANSING 3511 -1300
- BKC 3731 -1520
- CONGL 3762 -1551
- ARBUCKLE 3779 -1568

