


Give All Information Completely
Make Required Affidavit
Mail or Deliver Report to:
Conservation Division
State Corporation Commission
800 Biting Building
Wichita, Kansas

OR
FORMATION PLUGGING RECORD

Strike out upper line
when reporting plug-
ging off formations.

Ellis County. Sec. 10 Twp. 12 Rge. 18(B) (W)
Location as "NE $\frac{1}{4}$ NW $\frac{1}{4}$ SW $\frac{1}{4}$ " or footage from lines. CSL SE NE NE
Lease Owner William Graham Oil Company
Lease Name Baker Well No. #2
Office Address 204 North Market, Wichita, Kansas
Character of Well (completed as Oil, Gas or Dry Hole) Dry Hole
Date well completed November 1 19 49
Application for plugging filed November 3 19 49
Application for plugging approved November 2 19 49
Plugging commenced November 1 19 49
Plugging completed November 1 19 49
Reason for abandonment of well or producing formation dry

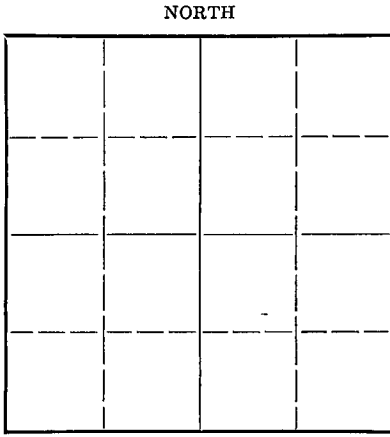

Locate well correctly on above
Section Plat

If a producing well is abandoned, date of last production 19
Was permission obtained from the Conservation Division or its agents before plugging was com-
menced? yes

Name of Conservation Agent who supervised plugging of this well Eldon Petty
Producing formation _____ Depth to top _____ Bottom _____ Total Depth of Well _____ Feet
Show depth and thickness of all water, oil and gas formations.

OIL, GAS OR WATER RECORDS

CASING RECORD

Formation	Content	From	To	Size	Put In	Pulled Out
				8 5/8"	165'	none

Describe in detail the manner in which the well was plugged, indicating where the mud fluid was placed and the method or methods used in introducing it into the hold. If cement or other plugs were used, state the character of same and depth placed, from _____ feet to _____ feet for each plug set.

Mud and rock to 165'.
Plug set at 165' with 15 sacks
cement, mud to 30', 10 sacks cement,
mud to surface.

RECEIVED
11-7-1949
NOV 7 1949
STATE CORPORATION COMMISSION
KANSAS

(If additional description is necessary, use BACK of this sheet)

Correspondence regarding this well should be addressed to William Graham Oil Company
Address 204 N. Market, Wichita, Kansas

STATE OF KANSAS, COUNTY OF SEDGWICK, SS. _____
(employee of owner) or (owner or operator) of the above-described well,
being first duly sworn on oath, says: That I have knowledge of the facts, statements, and matters herein contained and the log of the above-
described well as filed and that the same are true and correct. So help me God.

(Signature) William Graham

(Address)

SUBSCRIBED AND SWORN to before me this 5 day of November, 19 49

J. H. Anderson
Notary Public.

My commission expires Dec. 2, 1951

PLUGGING
FILE SEC 10 T 18 R 18 W
BOOK PAGE 177 LINE 76

15-05704404-00-00

WELL RECORD

BAKER #2

Location: CSL SE NE NE
Sec. 10 - 12 - 18W
Ellis County, Kansas

Commenced: October 23, 1949

Completed: November 1, 1949

Operator: William Graham Oil Company
204 North Market
Wichita, Kansas

Production: Dry Hole

Contractor: William Graham Oil Company
Same

Casing Record: Set 165' of 8 5/8" Surface Casing
Cemented same with 130 sacks regular
cement.

LOG

(Figures indicate bottom of formation)

Shale	140
Shale and shells	650
Sand and shale	905
Shale	1250
Red shale	1390
Anhydrite	1425
Shale and shells	1805
Salt	1945
Lime and shale	2650
Shale and lime	2825
Lime and shale	3175
Shale and lime	3230
Lime	3635
Lime and shale	3668
Lime	3678
Chert and lime	3690
Lime	3700
Total Depth (Rotary)	3700

The undersigned, WILLIAM GRAHAM OIL COMPANY, hereby certifies that the above log is a true and correct log of the formation encountered in drilling the above noted well as reflected by the Daily Drilling Reports.

WILLIAM GRAHAM OIL COMPANY

11-7-1949

By William L. Graham
Owner

STATE OF KANSAS)
) ss.
COUNTY OF SEDGWICK)

Be it remembered that on this 3rd day of November, 1949 before me the undersigned, a notary public, duly commissioned in and for the County and State aforesaid, came William L. Graham, Owner of WILLIAM GRAHAM OIL COMPANY, a Partnership of the State of Kansas, personally known to me to be such officer, and to be the same person who executed as such officer the foregoing instrument of writing on behalf of said Partnership, and he duly acknowledged the execution of the same for himself and for said Partnership.

IN WITNESS WHEREOF, I have hereunto set my hand and official seal on the day and year last above written.

John Andrew
Notary Public

My Commission Expires:

Recording stamp: PLUGGING
FILE 20210718 R18W
BOOK PAGE 127 LINE 26

Notary seal: My Commission Expires: Dec 2, 1951