

STATE OF KANSAS
STATE CORPORATION COMMISSION


15-051-23114-00-00

WELL PLUGGING RECORD

Give All Information Completely
Make Required Affidavit
Mail or Deliver Report to
Conservation Division
State Corporation Comm.
245 North Water
Wichita, KS 67202

Ellis County, Sec. 10 Twp. 12 Rge. 18 ~~EX~~W
Location as "NE/CNW $\frac{1}{4}$ SW $\frac{1}{4}$ " or footage from lines
SWNESW

Lease Owner Dreiling Ltd. of Colorado
Lease Name Baker Well No. 2
Office Address 410 - 17th St., Suite 1140, Denver, Co. 80202
Character of Well (Completed as Oil, Gas or Dry Hole)

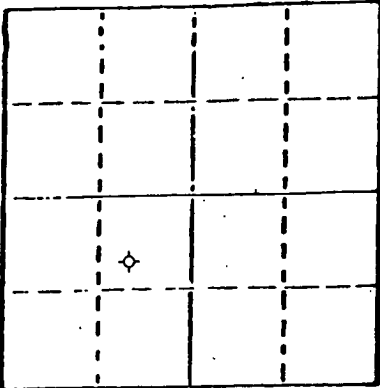

Locate well correctly on above
Section 7 list

Dry Hole
Date Well completed 9-4 19 82
Application for plugging filed 9-7 19 82
Application for plugging approved 9-3 19 82
Plugging commenced 9-3 10:45 P.M. 19 82
Plugging completed 9-4 12:30 A.M. 19 82
Reason for abandonment of well or producing formation
Non-productive

If a producing well is abandoned, date of last production
None 19

Was permission obtained from the Conservation Division or
its agents before plugging was commenced? Yes

Name of Conservation Agent who supervised plugging of this well Carl Goodrow
Producing formation _____ Depth to top _____ Bottom _____ Total Depth of Well 3780
Show depth and thickness of all water, oil and gas formations.

OIL, GAS OR WATER RECORDS

CASING RECORD

FORMATION	CONTENT	FROM	TO	SIZE	PUT IN	PULLED OUT
				8-5/8	207	None

Describe in detail the manner in which the well was plugged, indicating where the mud fluid was placed and the method or methods used in introducing it into the hold. If cement or other plugs were used, state the character of same and depth placed, from _____ feet to _____ feet for each plug set. Hole full of heavy mud. Cement plugs with 170 sacks 50-50 pozmix with 6% gel, 3% cc. cemented through drill pipe as follows:
1st cement plug at 660' with 100 sacks
2nd cement plug at 250' with 40 sacks
3rd wood and rubber 8-5/8" plug with solid hull bridge at 40' with 10 sacks
10 sacks in mousehole
10 sacks in rathole

(If additional description is necessary, use BACK of this sheet)

Name of Plugging Contractor Hallibruton

STATE OF Colorado COUNTY OF Denver, ss.
Leslie Olson (employee of owner) or ~~(owner or operator)~~
of the above-described well, being first duly sworn on oath, says: That I have knowledge of the facts, statements, and matters herein contained and the log of the above-described well as filed and that the same are true and correct. So help me God.

(Signature) *Leslie Olson*
410 - 17th St., Suite 1140, Denver, Co. 80202
(Address)

SUBSCRIBED AND SWORN TO before me this 7th day of September, 1982

Lorraine C. Murphy
Notary Public.

My commission expires 9-2-83

RECEIVED
STATE CORPORATION COMMISSION
9-9-1982
SEP 09 1982
CONSERVATION DIVISION
Wichita, Kansas