

15-051-01390-00-00
WELL PLUGGING RECORD

OR

FORMATION PLUGGING RECORD

Strike out upper line when reporting plugging off formations.

NORTH

**Locate well correctly on above
Section Plat**

Ellis County. Sec. 10 Twp. 12 Rge. 18 (E) (W)

Location as "NE $\frac{1}{4}$ NW $\frac{1}{4}$ SW $\frac{1}{4}$ " or footage from lines..... SW SW NW

Lease Owner: Lario Oil & Gas Company

Lease Name Baker Bros Well No.

Office Address 301 S Market Street, Wichita, Kansas.

Character of Well (completed as Oil, Gas or Dry Hole) Dry

Date well completed.....12-5-45.....19

Date when completed.....12-5-45.....19.....

Application for plugging filed.....19.....

Application for plugging approved.....12-5-45.....19

Application for plugging approved.....	12-5-45	19
Plugging commenced.....		19

Plugging completed.....	12-5-45	19
-------------------------	---------	----

Reason for abandonment of well or producing formation..... Dry

.....

If a producing well is abandoned, date of last production.....	19.....
--	---------

Was permission obtained from the Conservation Division or its agents before plugging was com-

Was permission obtained from the Conservation Division of the Agents before tagging was commenced? Yes

Name of Conservation Agent who supervised plugging of this well.....

Producing formation..... Depth to top..... Bottom..... Total Depth of Well.....**3802**.....Feet

Show depth and thickness of all water, oil and gas formations.


OIL, GAS OR WATER RECORDS

CASING RECORD

[illegible]

Describe in detail the manner in which the well was plugged, indicating where the mud fluid was placed and the method or methods used in introducing it into the hold. If cement or other plugs were used, state the character of same and depth placed, from.....feet tofeet for each plug set.

Heavy mud to 145' bottom of 12 $\frac{1}{2}$ "
surface pipe - 20 sax cement -
mudded to surface and capped with
10 sax cement at top of hole.

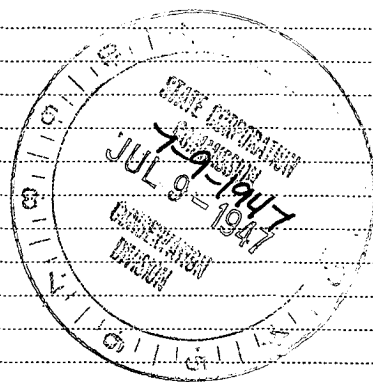

(If additional description is necessary, use BACK of this sheet)

Correspondence regarding this well should be addressed to.....
Address..... **301 S. Market Street, Wichita, Kansas.**

STATE OF KANSAS, COUNTY OF SEDGWICK, ss.
H. W. Lewis, Partner (employee of owner) or (owner or operator) of the above-described well

being first duly sworn on oath, says: That I have knowledge of the facts, statements, and matters herein contained and the log of the above-described well as filed and that the same are true and correct. So help me God. **THREE-WAY DRILLING COMPANY**

(Signature)..... By [Signature]
607-10 Union Natl Bank Bldg. Wichita, Ks.

607-10 Union Natl Bank Bldg. Wichita. Ks.

(Address) 47

SUBSCRIBED AND SWORN to before me this

day of

~~December~~

19.....

Notary Public.

My commission expires.

20-1300-s 11-43-10M



PLUGGING
FILE SEC 10 T 12 R 18W
BOOK PAGE 35 LINE 44


15-051-01390-00-00
WELL LOG BUREAU KANSAS GEOLOGICAL SOCIETY
412 Union National Bk. Bldg., Wichita, Kansas

Company. GLOBE OIL & REFG. CO.
Farm Baker Bros. No. 1.

SEC. 10 T. 12 R. 18 W
SWc NW

Total Depth. 3802
Comm. 11-15-45 Comp. 12-5-45
Shot or Treated.
Contractor. Three Way Drlg. Co.
Issued. 12-22-45

County. Ellis
KANSAS

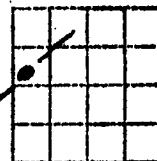

CASING:
12 $\frac{1}{2}$ " 148' Cem.



Elevation. _____

Production. Dry

Figures Indicate Bottom of Formations.

shale	100
shale & shells	280
shale	900
shale & shells	1280
red rock	1470
anhydrite shale	1495
shale	1595
shale & lime shells	1905
shale & shells	2055
lime	2315
lime brkn	2387
lime & shale	2470
lime	2590
lime brkn	2695
lime	2845
lime & shale	3050
lime brkn	3120
lime & shale	3180
lime	3604
lime & chert	3617
lime	3695
lime & chert	3717
lime	3755
dolomite	3802
Total Depth	

Tops:
Anhydrite 1461
Topeka 2140
Conglomerate 3742
Arbuckle 3750

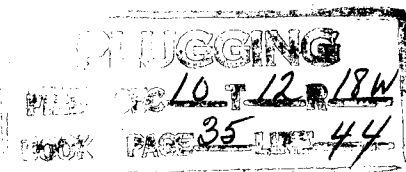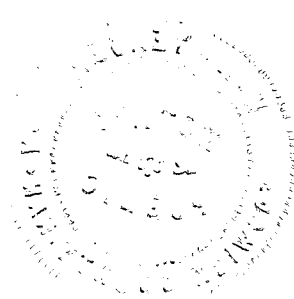

STATE OF KANSAS

SS

COUNTY OF SEDGWICK

H. W. Lewis, The Three Way Drilling Company, of lawful age, being first duly sworn under oath, states that the Three Way Drilling Company was the contractor engaged for the drilling of Baker No. 1, located in the SW S¹ NW 10-12-18W, Ellis County Kansas, and that the foregoing log is a true and correct copy of the log of the completed well.

THREE WAY DRILLING COMPANY

BY

H. W. Lewis

Subscribed and sworn to before me, a Notary Public, in and for the County and State above mentioned, this 13th day of December, 1945.

W. H. Granger
Notary Public

My commission expires
February 5, 1949.