


STATE OF KANSAS
STATE CORPORATION COMMISSION

WELL PLUGGING RECORD

Give All Information Completely
Make Required Affidavit
Mail or Deliver Report to:
Conservation Division
State Corporation Commission
800 Biting Building
Wichita, Kansas

NORTH

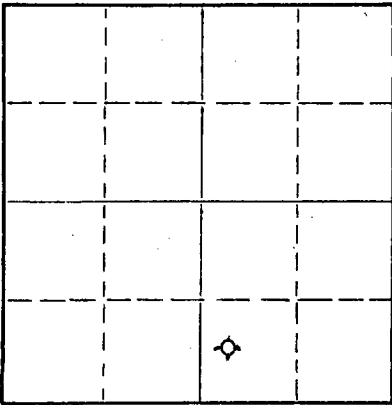

Locate well correctly on above
Section Plat

Rooks County. Sec. 14 Twp. 10 Rge. 20 (E) W (W)
Location as "NE/CNWxSWx" or footage from lines C W/2 SE SW
Lease Owner C-G Drilling Co.
Lease Name Moore Well No. 4
Office Address 107 Rule Building, Wichita, Kansas
Character of Well (completed as Oil, Gas or Dry Hole) Dry Hole
Date well completed 1-5 19 55
Application for plugging filed 1-5 19 55
Application for plugging approved 1-5 19 55
Plugging commenced 1-5 19 55
Plugging completed 1-5 19 55
Reason for abandonment of well or producing formation Lost drill pipe in hole.

If a producing well is abandoned, date of last production -- 19 --
Was permission obtained from the Conservation Division or its agents before plugging was commenced? Yes

Name of Conservation Agent who supervised plugging of this well Eldon Petty, Hays, Kansas
Producing formation -- Depth to top -- Bottom -- Total Depth of Well 2950 Feet
Show depth and thickness of all water, oil and gas formations.

OIL, GAS OR WATER RECORDS

CASING RECORD

FORMATION	CONTENT	FROM	TO	SIZE	PUT IN	PULLED OUT
				8-5/8"	183.38'	None

Describe in detail the manner in which the well was plugged, indicating where the mud fluid was placed and the method or methods used in introducing it into the hole. If cement or other plugs were used, state the character of same and depth placed, from _____ feet to _____ feet for each plug set.

Filled hole with mud to 175'; set plug; 1/2 sack hulls, 15 sacks cement. Filled hole with mud to 40'; set plug then filled to top with 10 sacks cement, 1/2 sack hulls.

1-11-1955

(If additional description is necessary, use BACK of this sheet)

Name of Plugging Contractor C-G Drilling Co.
Address 107 Rule Building, Wichita, Kansas

STATE OF KANSAS, COUNTY OF SEDGWICK, ss.
Vicky Jacobs (employee of owner) or ~~owner~~ (operator) of the above-described well, being first duly sworn on oath, says: That I have knowledge of the facts, statements, and matters herein contained and the log of the above-described well as filed and that the same are true and correct. So help me God.

(Signature) Vicky Jacobs Office Manager
107 Rule Building, Wichita, Kansas (Address)

SUBSCRIBED AND SWORN TO before me this 10th day of January, 19 55

My commission expires June 17, 1957

Notary Public.

PLUGGING
FILE SEC 14 TWP 10 R 20W
BOOK 90 LINE 3

CONTRACTOR'S WELL LOG

OPERATOR C-G Drilling Co. FARM NAME Moore #4
 LOCATION C W/2 SE SW, Sec. 14-10-20W
 POOL NAME Marcotte COUNTY Rooks STATE Kansas
 COMMENCEMENT DATE 12-22-54 COMPLETION DATE 1-5-55

LOG OF WELL

Elevation: 2235 R.B.
 All measurements from the top of rotary bushing.

FROM	TO	FORMATION	DEVIATION FROM VERTICAL	REMARKS:
0	75	Shale-Shells-Sand		
75	183	Shale-Shells-Sand		
183	970	Shale-Shells-Sand		
970	1540	Shale-Shells-Sand	0° - 1500'	
1540	1657	Red Bed		
1657	1698	Anhydrite		
1698	1960	Shale		
1960	2330	Lime-Shale	0° - 2000'	
2330	2470	Lime-Shale		
2470	2605	Lime-Shale	0° - 2500'	
2605	2760	Lime-Shale		
2760	2900	Lime-Shale		
2900	2950	Lime-Shale		

CASING LEFT IN HOLE AFTER COMPLETION

Ran 183.38' of 8-5/8" Surface Casing.

STATE OF KANSAS }
 COUNTY OF SEDGWICK } ss.

The undersigned certifies that to the best of her knowledge and belief, the above facts are true and correct.

C-G DRILLING CO.

By Vicky Jacobs
 Office Manager

Subscribed and sworn to before me this 10th day of January, 1955.

My commission expires: June 17, 1957

Barbara Donaldson
 Notary Public



PLUGGING
 FILE SEC 14-10-R-20W
 BOOK PAGE 90 LINE 3

1-11-1955