

STATE OF KANSAS
STATE CORPORATION COMMISSION


WELL PLUGGING RECORD

Give All Information Completely
Make Required Affidavit
Mail or Deliver Report to:
Conservation Division
State Corporation Commission
800 Bittling Building
Wichita, Kansas

Rooks County. Sec. 14 Twp. 10S Rge. (E) 20 (W)
NE NE NE

Location as "NE/CNW/SW 1/4" or footage from lines
Lease Owner **Nadel & Gussman**
Lease Name **Stithem** Well No. **1**
Office Address **Petroleum Building, Tulsa, Oklahoma**
Character of Well (completed as Oil, Gas or Dry Hole) **Dry Hole**
Date well completed **January 23 19 49**
Application for plugging filed **January 22 19 49**
Application for plugging approved **January 22 19 49**
Plugging commenced **January 23 19 49**
Plugging completed **January 23 19 49**
Reason for abandonment of well or producing formation **Dry Hole**

NORTH

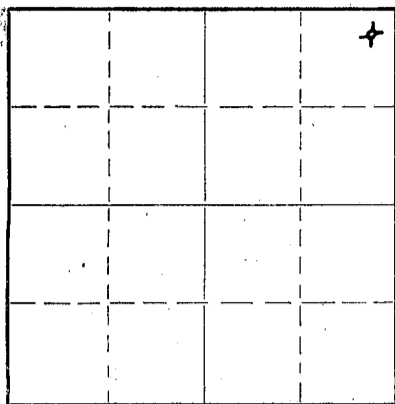

Locate well correctly on above
Section Plat

If a producing well is abandoned, date of last production 19
Was permission obtained from the Conservation Division or its agents before plugging was commenced? **Yes**

Name of Conservation Agent who supervised plugging of this well **C. D. Stough**
Producing formation Depth to top Bottom Total Depth of Well **3850** Feet
Show depth and thickness of all water, oil and gas formations.

OIL, GAS OR WATER RECORDS

CASING RECORD

Formation	Content	From	To	Size	Put In	Pulled Out
		0	191	10 3/4	191	None

Describe in detail the manner in which the well was plugged, indicating where the mud fluid was placed and the method or methods used in introducing it into the hole. If cement or other plugs were used, state the character of same and depth placed, from feet to feet for each plug set.

3850' - 192' - Heavy Rotary Mud
 192' - 190' - Wooden Plug
 190' - 163' - 20 sacks cement
 163' - 27' - Heavy Rotary Mud
 27' - 25' - Wooden Plug
 25' - 6' - 10 sacks cement & rock
 6' - surface - Cellar

1-28-1949

(If additional description is necessary, use BACK of this sheet)

Correspondence regarding this well should be addressed to **Nadel & Gussman**
Address **Petroleum Building**
Tulsa, Oklahoma

STATE OF **Kansas**, COUNTY OF **Barton**, ss.
Glenne Peel Drilling Company, Inc. (employee of owner) or (owner or operator) of the above-described well,

being first duly sworn on oath, says: That I have knowledge of the facts, statements, and matters herein contained and the log of the above-described well as filed and that the same are true and correct. So help me God. **GLENNE PEEL DRILLING COMPANY, INC.**


(Signature) BY: *Murdell E. Peel*

P.O. Box 359, **Boisington, Kansas**
(Address)

SUBSCRIBED AND SWORN TO before me this **25th** day of **January**, 19**49**.

Marian M. Herber
Notary Public.

My commission expires **June 4, 1951**

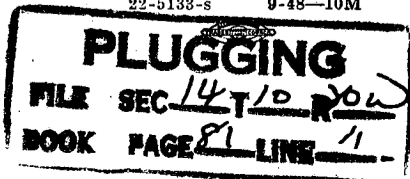

DRILLER'S LOG

Company: Madel & Gusman

Sec. 14 Twp. 10S Rge. 20W
NE NE NE

Farm: Stithen Well No. 1

County: Rooks,
Kansas

Total Depth: 3850'

Comm.: 1-8-49 Comp.: 1-23-49

Contractor: Glenn Peal Drilling Co., Inc.

Elevation:

Casing:
10 3/4" 191' con.

Production: Dry

Figures below indicate bottom of formations

Surface Clay	0 -	25
Sand		40
Shale		194
Shale and Shells		750
Shale and Sand		950
Shale and Shells		1110
Sand		1315
Shale and Shells		1648
Anhydrite		1678
Shale and Red Bed		1925
Shale and Shells		2110
Shale and Broken Lime		2232
Lime and Shale		2372
Lime		2500
Lime and Shale		2540
Lime		2790
Shale and Lime		2838
Lime		2960
Lime and Shale		3047
Shale and Lime		3157
Lime and Shale		3320
Lime		3784
Lime and Green Shale		3817
Lime		3850
Total Depth		3850

This is to certify that the above information is, to the best of our knowledge, true and correct.

GLENN PEAL DRILLING CO., INC.

BY: Mendell E. Peal

SUBSCRIBED AND SWORN to before me this 25th day of January, 1949

My commission expires June 4, 1951

Marian M. Herbert
Notary Public

1-28-1949

PLUGGING
FILE SEC. 14T 10 R206
BOOK PAGE 81 LINE 11