


STATE OF KANSAS
STATE CORPORATION COMMISSION
200 Colorado Derby Bldg.
Wichita, Kansas 67202

Form CP-4
Rev. 12-15-80

WELL PLUGGING RECORD

Give All Information Completely
Make Required Affidavit

COUNTY Rooks SEC. 14 TWP. 10S RGE. 20W EXW
Location as in quarters or footage from lines:
NW NW NW

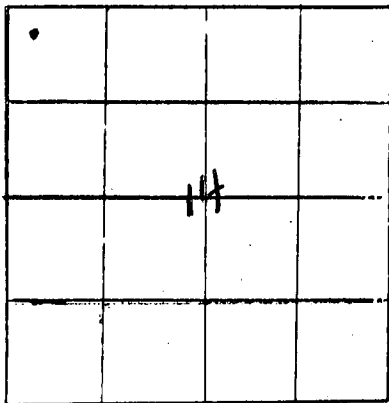

Locate Well
correctly on above
Section Platt.

Lease Owner Nadel and Gussman
Lease Name STITHEM Well No. 1
Office Address .3232 First National Tower-Tulsa, OK 74103
Character of Well (Completed as Oil, Gas or Dry Hole): _____
Date Well Completed Feb. 5, 1950
Application for plugging filed 8/30/82
Plugging commenced 9/16/82
Plugging completed 9/16/82
Reason for abandonment of well or producing formation Depleted

Was permission obtained from the Conservation Division or it's
Agent's before plugging was commenced? yes

Name of Conservation Agent who supervised plugging of this well Dennis Hamel & Carl Goodrow
Producing formation Arbuckle Depth to top 3773 bottom 3775 T.D. 3778
Show depth and thickness of all water, oil and gas formations.

OIL, GAS OR WATER RECORDS

Casing Record

Formation	Content	From	To	Size	Put in	Pulled Out
Arbuckle	oil(depleted)	3773	3775	8"	163'	none
				5 1/2"	3775'	none

Describe in detail the manner in which the well was plugged, indicating where the mud
fluid was placed and the method or methods used in introducing it into the hold. If cement
or other plugs were used, state the character of same and depth placed, from _____ feet
to _____ feet for each plug set.

350 sacks of 50/50 Poz, 6% gel, 3% calcium chloride and 3 sacks of hulls were
pumped down the 8" and 5 1/2" annulus at the same time. SIP 800#

RECEIVED
STATE CORPORATION COMMISSION
10-01-1982
OCT 01 1982
CONSERVATION DIVISION
Wichita, Kansas

(If additional description is necessary, use BACK of this sheet)

Name of Plugging Contractor Allied Cementing Company (Russell, Ks.)

STATE OF Oklahoma COUNTY OF Tulsa, ss.

M. R. Taylor, Mgr. of Production (employee of owner) or (owner or operator) of the
above-described well, being first duly sworn on oath, says: That I have knowledge of the
facts, statements, and matters herein contained and the log of the above-described well as
filed and that the same are true and correct. So help me God.

(Signature) M R Taylor
3232 First National Tower-Tulsa, OK 74103
(Address)

SUBSCRIBED AND SWORN TO before me this 29th day of September, 1982

Mildred Carter
Mildred Carter Notary Public.

My Commission expires: 5/11/83



WELL LOG

NADEL AND GUSSMAN

No. 1 STITHEM

NWc 14-10S-20W
Rooks County, KansasComm. 1-26-50
Comp. 2- 5-50Casing:
163' 8" w/ 125 sacks cem.
3775' 5½" w/100 sax cement.RECEIVED
STATE CORPORATION COMMISSION9-1-1982
SEP 1 1982CONSERVATION DIVISION
Wichita, Kansas

<u>Formations</u>	<u>Depth</u>
Shale and sand	163
Shale and shells	1225
Sand	1370
Shale and Red rock	1650
Anhydrite	1695
Shale, shells & Red bed	2110
Shale and shells	2320
Shale and lime	2455
Broken lime	2550
Lime	2580
Shale and lime	2730
Shale and shells	2865
Shale and lime	2885
Lime	2925
Shale and lime	3362
Lime	3442
Shale	3481
Lime	3733
Conglomerate	3748
Shale	3774
Lime	3778

Geological Tops

Heebner Shale	3443
Toronto	3461
Lansing-Kansas City	3481
Conglomerate	3733
Simpson Shale	3748
Arbuckle	3771-3778 T.D.

STATE OF KANSAS

COUNTY OF SEDGWICK

) SS:
)

L. C. Hay of lawful age being first duly sworn on his oath states that the above formations and depths are true and correct as taken from the daily drilling report of Stithem No. 1 in the NWc of 14-10S-20W, Rooks County, Kansas.

L. C. Hay

Subscribed and sworn to before me this 13th day of February, 1950.

Wesley B. Bandy
Notary Public

My commission expires Nov. 3, 1952