

STATE OF KANSAS
STATE CORPORATION COMMISSION

WELL PLUGGING RECORD


OR
FORMATION PLUGGING RECORD

Strike out upper line
when reporting plug-
ging off formations.

Give All Information Completely
Make Required Affidavit
Mail or Deliver Report to:
Conservation Division
State Corporation Commission
800 Bitting Building
Wichita, Kansas

Rooks County, Sec. 14 Twp. 10S Rge. 20 ~~(E)~~ (W)

Location as "NE $\frac{1}{4}$ NW $\frac{1}{4}$ SW $\frac{1}{4}$ " or footage from lines SW SW NW
Lease Owner Star Ferrier Drilling Co, et al
Lease Name Stithem Well No. 1
Office Address Bitting Bldg., Wichita 2, Kansas
Character of Well (completed as Oil, Gas or Dry Hole) Dry Hole
Date well completed Oct. 18, 1945 19
Application for plugging filed Nov. 11, 1945 19
Application for plugging approved Nov. 16, 1945 19
Plugging commenced Nov. 5, 1945
Plugging completed Nov. 11, 1945
Reason for abandonment of well or producing formation
Dry hole
If a producing well is abandoned, date of last production..... 19
Was permission obtained from the Conservation Division or its agents before plugging was com-
menced? Yes, from Mr. Kerr

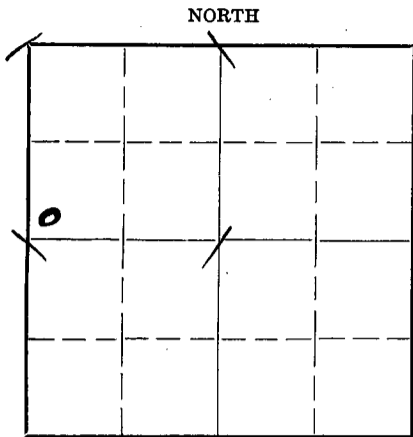

Locate well correctly on above
Section Plat

Name of Conservation Agent who supervised plugging of this well..... H. W. Kerr, Great Bend, Kans.
Producing formation..... Depth to top..... Bottom..... Total Depth of Well 3826 Feet
Show depth and thickness of all water, oil and gas formations.

OIL, GAS OR WATER RECORDS

CASING RECORD

Formation	Content	From	To	Size	Put In	Pulled Out
				10"	209'	cemented
				5 $\frac{1}{2}$ "	3787'	3130'

Describe in detail the manner in which the well was plugged, indicating where the mud fluid was placed and the method or methods used in introducing it into the hold. If cement or other plugs were used, state the character of same and depth placed, from..... feet to..... feet for each plug set.

5 $\frac{1}{2}$ " was run & cemented 3787' - 657' was left in and cemented with Lane Wells Plug to 3570'. Then dumped cement with bailer to 3500', then dumped mud to 209'; Cement plug, dumped with bailer, 209 to 175'; dumped cement to 5' from top.



14 10 20W
33 27

(If additional description is necessary, use BACK of this sheet)

Correspondence regarding this well should be addressed to Ferrier Drilling Co.
Address 607 Bitting Building, Wichita 2, Kansas

STATE OF Kansas, COUNTY OF Sedgwick, ss.
T. L. Ferrier (employee of owner) or (owner or operator) of the above-described well,

being first duly sworn on oath, says: That I have knowledge of the facts, statements, and matters herein contained and the log of the above-described well as filed and that the same are true and correct. So help me God.

(Signature) T. L. Ferrier

Wichita 2, Kansas
(Address)

SUBSCRIBED AND SWORN to before me this 16th day of November, 1945.

My commission expires Sept. 24, 1949 Notary Public.

15-163-00262-00-00

DESCRIPTION

State **Kansas** Company **Ferrier Drig. Co.**

County **Roake** Farm **Stithem** Well No. **1**

Survey **SW/4 NW/4 14-103-20W**

T. R. Contractor **Ferrier Drig. Co.**

Commenced **9/15/45**

Completed ~~**10/2/45**~~ **10/18/45**

Remarks

Altitude
2226

Production
Dry

CASING RECORD
10 1/2" **200 ft.**

8 1/4"

20 "

6 5/8"

15 1/2"

5 3/16"

12 1/2"

5 1/2" **3787 ft.**

Shot Quarts Between


LOG

Top	Bottom	Formation and Remarks
0	80	Lime & sand
80	216	Lime & shale
216	590	Shale & shells
590	665	Broken lime
665	825	Shale & shells
825	885	Sand
885	1030	Broken lime & shale
1030	1375	Lime & sand
1375	1436	Shale
1436	1462	Anhydrite
1462	1650	Shale & shells
1650	1720	Lime
1720	1770	Lime & Shale
1770	1950	Red Bed & lime (shells)
1950	2025	Broken lime & shale
2025	2145	Shale & Shells
2145	2155	Broken lime
2155	2241	Broken lime & shale
2241	2265	Shale
2265	2271	Lime
2271	2495	Broken lime & shale
2495	2525	Shale & shells
2525	2720	Hard shale
2720	2760	Shale
2760	2965	Broken lime & shale
2965	2995	Broken lime
2995	3251	Shale & shells
3251	3308	Lime
3308	3376	Broken lime
3376	3410	Lime & shale
3410	3477	Lime
3477	3585	Lime (chert)
3585	3620	Lime
3620	3636	Lime & shale
3636	3785	Broken lime & shale
3785	3790	chert
3790	3826	Conglomerate

Log—Continued

Top Bottom Formation and Remarks

STANDARD [189] FORM FOR SALE BY MID-WEST PTG. CO. PRINTED IN TULSA, OKLA., U.S.A.

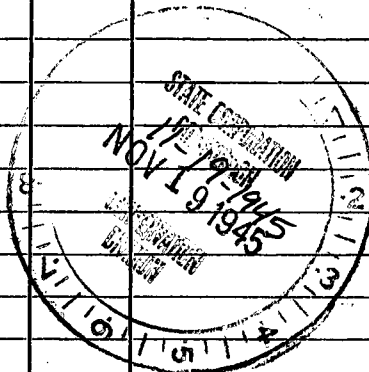

14 10 20W
33 27

