

RECEIVED
STATE CORPORATION COMMISSION Form CP-4
10-1-1982
OCT 01 1982
Rev. 12-15-80


STATE OF KANSAS
STATE CORPORATION COMMISSION
200 Colorado Derby Bldg.
Wichita, Kansas 67202

CONSERVATION DIVISION
Wichita, Kansas

WELL PLUGGING RECORD

Give All Information Completely
Make Required Affidavit

COUNTY Rooks SEC. 14 TWP. 10S RGE. 20W EXW
Location as in quarters or footage from lines:
C SL SE NE

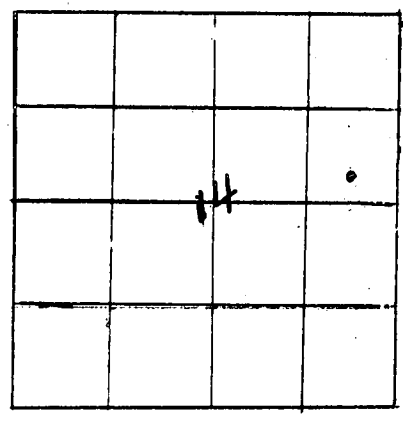

Locate Well
correctly on above
Section Platt.

Lease Owner Nadel and Gussman
Lease Name STITHEM Well No. 18
Office Address. 3232 First National Tower-Tulsa, OK 74103
Character of Well (Completed as Oil, Gas or Dry Hole): oil
Date Well Completed March 29, 1954
Application for plugging filed 8/30/82
Plugging commenced 9/16/82
Plugging completed 9/16/82
Reason for abandonment of well or producing formation Depleted

Was permission obtained from the Conservation Division or it's Agent's before plugging was commenced? yes

Name of Conservation Agent who supervised plugging of this well Dennis Hamel & Carl Goodrow
Producing formation, Arbuckle Depth to top 3741' bottom 3744' T.D. 3744'
Show depth and thickness of all water, oil and gas formations.

OIL, GAS OR WATER RECORDS Casing Record

Formation	Content	From	To	Size	Put in	Pulled Out
Arbuckle	oil(depleted)	3741	3744			
				10-3/4"	124'	none
				7"	3742'	none

Describe in detail the manner in which the well was plugged, indicating where the mud fluid was placed and the method or methods used in introducing it into the hold. If cement or other plugs were used, state the character of same and depth placed, from feet to feet for each plug set.

350 sacks of 50/50 Poz, 6% gel, 3% calcium chloride, and 3 sacks of hulls were pumped down the 10-3/4" and 7" annulus at the same time. SIP 500#

(If additional description is necessary, use BACK of this sheet)

Name of Plugging Contractor Allied Cementing Company (Russell, Ks.)

STATE OF Oklahoma COUNTY OF Tulsa, ss.
 (employee of owner) or (owner or operator) of the above-described well, being first duly sworn on oath, says: That I have knowledge of the facts, statements, and matters herein contained and the log of the above-described well as filed and that the same are true and correct. So help me God.

(Signature) *M A Taylor*
3232 First National Tower-Tulsa, OK 74103
(Address)

SUBSCRIBED AND SWORN TO before me this 29th day of September, 1982



Mildred Carter
Notary Public.

My Commission expires: 5/11/83

WELL LOG

NADEL AND GUSSMAN

STITHEM No. 18

C SL SE NE 14-10-20W,
Rooks County, Kansas

Comm: 3-17-54
Comp: 3-29-54

Casing: 10-3/4" 124' w/100 sax
7" 3742' w/75 sax

<u>Formations</u>	<u>Depth</u>
Sand and red bed	130
Sand and shale	1050
Shale	1140
Sand	1365
Shale and red rock	1651
Anhydrite	1688
Shale and shell	1820
Shale	1975
Shale and lime	2330
Lime	2486
Shale and lime	2555
Lime	2675
Shale and lime	2775
Lime	2865
Shale and lime	3325
Lime	3370
Shale and lime	3405
Lime	3674
Shale and lime	3691
Conglomerate	3734
Shale	3741
Dolomite	3744

Geological Tops

Heebner	3423
Lansing-K.C.	3461
Conglomerate	3691
Simpson Shale	3734
Arbuckle	3741

RECEIVED
STATE CORPORATION COMMISSION
9-1-1982
SFP 1 1982

CONSERVATION DIVISION
Wichita, Kansas

STATE OF KANSAS)
) SS:
COUNTY OF SEDGWICK)

L. C. Hay of lawful age, deposes and states that the above depths and formations are correct as shown by the daily drilling log of the Stithem Well No. 18 in the cSL SE NE 14-10-20W, Rooks County, Kansas.

L. C. Hay

Subscribed and sworn to before me this 2nd day of April, 1954.

W. B. Babby
Notary Public

My commission expires Nov. 3, 1956