


STATE OF KANSAS
STATE CORPORATION COMMISSION
200 Colorado Derby Bldg.
Wichita, Kansas 67202

Form CP-4
Rev. 12-15-80

WELL PLUGGING RECORD

Give All Information Completely
Make Required Affidavit

COUNTY Rooks SEC. 14 TWP 10S RGE. 20W ~~20W~~
Location as in quarters or footage from lines:
SW NW SE

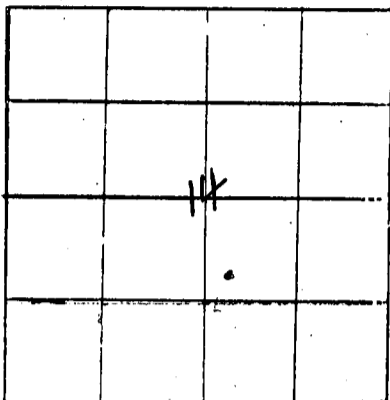

Locate Well
correctly on above
Section Platt.

Lease Owner Nadel and Gussman
Lease Name ELIZA Well No. 2
Office Address. 3232 First National Tower-Tulsa, OK 74103
Character of Well (Completed as Oil, Gas or Dry Hole): oil
Date Well Completed Sept. 11, 1951
Application for plugging filed 8/30/82
Plugging commenced 9/16/82
Plugging completed 9/16/82
Reason for abandonment of well or producing formation Depleted

Was permission obtained from the Conservation Division or it's Agent's before plugging was commenced? yes

Name of Conservation Agent who supervised plugging of this well Dennis Hamel & Carl Goodrow
Producing formation Arbuckle Depth to top 3768 bottom 3773 T.D. 3773

Show depth and thickness of all water, oil and gas formations.

OIL, GAS OR WATER RECORDS Casing Record

Formation	Content	From	To	Size	Put in	Pulled Out
<u>Arbuckle</u>	<u>oil(depleted)</u>	<u>3768</u>	<u>3773</u>	<u>8-5/8"</u>	<u>123'</u>	<u>none</u>
				<u>5-1/2"</u>	<u>3770'</u>	<u>none</u>

Describe in detail the manner in which the well was plugged, indicating where the mud fluid was placed and the method or methods used in introducing it into the hold. If cement or other plugs were used, state the character of same and depth placed, from _____ feet to _____ feet for each plug set.

250 sacks of 50/50 Poz, 6% gel and 3% Calcium Chloride, mixed with 3 sacks of hulls were pumped down the 8-5/8" and 5-1/2" annulus at the same time. SIP 400#

RECEIVED
STATE CORPORATION COMMISSION

OCT 01 1982
10-1-1982
CONSERVATION DIVISION
Wichita, Kansas

(If additional description is necessary, use BACK of this sheet)

Name of Plugging Contractor Allied Cementing Company (Russell, Ks.)

STATE OF Oklahoma COUNTY OF Tulsa, ss.

M. R. Taylor, Mgr. of Production (employee of owner) or (owner or operator) of the above-described well, being first duly sworn on oath, says: That I have knowledge of the facts, statements, and matters herein contained and the log of the above-described well as filed and that the same are true and correct. So help me God.

(Signature) M R Taylor
3232 First National Tower-Tulsa, OK 74103
(Address)

SUBSCRIBED AND SWORN TO before me this 29th day of September, 19 82

Mildred Carter
Mildred Carter Notary Public.

My Commission expires: 5/11/83

WELL LOG

NADEL AND GUSSMAN

ELIZA No. 2

SW NW SE 14-10-20W
Rooks County, Kansas

Commenced 9- 3-51
Completed 9-11-51

Casing: 8-5/8" 123' w/100 sax
5-1/2" 3770' w/100 sax

Formation	Depth
Surface	123
Shale and shells	1180
Shale, shells, sand & red bed	1672
Anhydrite	1720
Shale and shells	2000
Broken lime and shale	2260
Lime and shale	3125
Shale	3135
Lime and shale	3508
Lime	3696
Conglomerate	3765
Shale	3768
Arbuckle	3772

Geological Tops

Heebner	3448
Toronto	3473
Lansing	3485
Conglomerate	3724
Simpson Shale	3765
Arbuckle	3768

RECEIVED
STATE CORPORATION COMMISSION
9-1-1982
SFP 1 1982
CONSERVATION DIVISION
Wichita, Kansas

STATE OF KANSAS

COUNTY OF SEDGWICK

} SS:

L. C. Hay, of lawful age, deposes and states that the above formations and depths are true and correct as shown by the daily drilling log of the Eliza No. 2 in the SW NW SE 14-10-20W, Rooks County, Kansas.

L. C. Hay

Subscribed and sworn to before me this 18th day of September, 1951.

Wala B...
Notary Public

My commission expires Nov. 3, 1952