


WELL PLUGGING RECORD

15-195-00107-00-00

Give All Information Completely
Make Required Affidavit
Mail or Deliver Report to:
Conservation Division
State Corporation Commission
212 North Market, Insurance Bldg.
Wichita, Kansas

NORTH

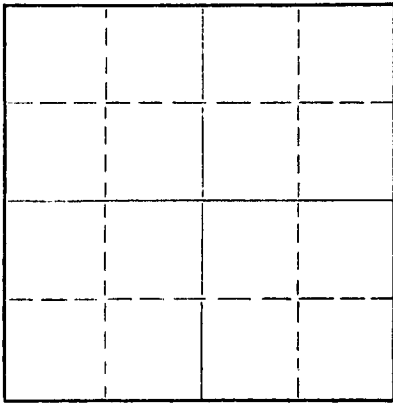

Locate well correctly on above
Section Plat

Trego County. Sec. 28 Twp. 12S Rge. 21 (X) W (W)
Location as "NE/CNW&SW¼" or footage from lines C NW NW
Lease Owner Davis Bros. - Transit Corporation
Lease Name Schoenthaler "F" Well No. 1
Office Address 1516 Liberty Bank Bldg., Okla. City, Oklahoma
Character of Well (completed as Oil, Gas or Dry Hole) D & A
Date well completed February 25, 19 59
Application for plugging filed February 25, 19 59
Application for plugging approved February 25, 19 59
Plugging commenced February 25, 19 59
Plugging completed February 25, 19 59
Reason for abandonment of well or producing formation No production

If a producing well is abandoned, date of last production _____ 19 ____
Was permission obtained from the Conservation Division or its agents before plugging was commenced? Yes

Name of Conservation Agent who supervised plugging of this well Gilbert P. Leiker-805 Main St., Victoria, Kansas
Producing formation _____ Depth to top _____ Bottom _____ Total Depth of Well _____ Feet
Show depth and thickness of all water, oil and gas formations.

OIL, GAS OR WATER RECORDS

CASING RECORD

FORMATION	CONTENT	FROM	TO	SIZE	PUT IN	PULLED OUT
				8 5/8"	192'	None

Describe in detail the manner in which the well was plugged, indicating where the mud fluid was placed and the method or methods used in introducing it into the hole. If cement or other plugs were used, state the character of same and depth placed, from _____ feet to _____ feet for each plug set.

Filled hole with heavy drilling mud to 600'; set plug, cemented with 20 sacks cement.
Filled hole with heavy drilling mud to 180'; set plug, cemented with 15 sacks cement.
Filled hole with heavy drilling mud to 40'; set plug, cemented with 10 sacks cement to bottom of cellar.

MAR 19 1959
STATE CONSERVATION DIVISION
Wichita, Kansas

(If additional description is necessary, use BACK of this sheet)

Name of Plugging Contractor Transit Corporation
Address 1516 Liberty Bank Building, Oklahoma City, Oklahoma

STATE OF Oklahoma, COUNTY OF Oklahoma, ss.
Paul E. Gathers (employee of owner) or (owner or operator) of the above-described well, being first duly sworn on oath, says: That I have knowledge of the facts, statements, and matters herein contained and the log of the above-described well as filed and that the same are true and correct. So help me God.

(Signature) Paul E. Gathers

(Address)

SUBSCRIBED AND SWORN TO before me this 10th. day of March, 19 59

Mildred Iron

My commission expires May 17, 1962

Notary Public.

PLUGGING
FILE SEC. 28 T. 12 R. 21 W
BOOK PAGE 21 LINE 39

15-195-00107-00-00

DRILLER'S WELL LOG

Davis Bros. - Transit Corporation - Schoenthaler "F" # 1 well located in
C NW NW Section 28-12S-21W,
Trego County, Kansas

Commenced: February 15, 1959
Completed: February 25, 1959
Elevation: 2243' KB

Casing 8 5/8" @ 192'
Cemented w/150 sacks

<u>Formation</u>	<u>From</u>	<u>To</u>
Clay, shell and red bed	0	100
Shale	100	1085
Sand	1085	1340
Shale, shells and red beds	1340	1651
Anhydrite	1651	1700
Shale	1700	2240
Shale and lime	2240	2490
Lime and shale	2490	2760
Shale	2760	2775
Shale and lime	2775	3000
Lime and shale	3000	3080
Shale and lime	3080	3270
Lime and shale	3270	3410
Lime	3410	3790
Lime and shale	3790	3842
Lime	3842	3890
Chert and conglomerate	3890	3942
Cherty lime	3942	3965 TD

Summary of Formation

Anhydrite	1651'
Topeka	3290'
Heebner	3508'
Toronto	3527'
Lansing	3542'
Base of K.C.	3781'
Conglomerate	3902'
Arbuckle	3945'

I hereby certify the foregoing to be a true and accurate Driller's Log of the formation encountered in the above well.

Subscribed and sworn to before me
this 10th. day of March, 1959.

TRANSIT CORPORATION

BY Paul E. Gathers

My Commission expires May 17, 1962.

Mildred Seon
Notary Public

FILED
STATE COMMISSION
MAR 19 1959
CONSERVATION DIVISION
Wichita, Kansas

PLUGGING
FILE SEC. 28 T. 12 R. 21W
BOOK PAGE 21 LINE 39