

STATE OF KANSAS
STATE CORPORATION COMMISSION


WELL PLUGGING RECORD

Give All Information Completely
Make Required Affidavit
Mail or Deliver Report to:
Conservation Division
State Corporation Commission
800 Bitting Building
Wichita, Kansas

Butler County, Sec. 6 Twp. 26S Rge. 3 (E) (W)

Location as "NE/CNW $\frac{1}{4}$ SW $\frac{1}{4}$ " or footage from lines E/2 NE NE
Lease Owner John P. Gaty
Lease Name Villapigue Well No. 1
Office Address 11 Cypress Drive, Wichita, Kansas
Character of Well (completed as Oil, Gas or Dry Hole) Dry Hole
Date well completed June 28 19 50
Application for plugging filed June 28 19 50
Application for plugging approved June 28 19 50
Plugging commenced July 3 19 50
Plugging completed July 3 19 50
Reason for abandonment of well or producing formation Dry Hole
If a producing well is abandoned, date of last production 19
Was permission obtained from the Conservation Division or its agents before plugging was commenced? Yes

NORTH

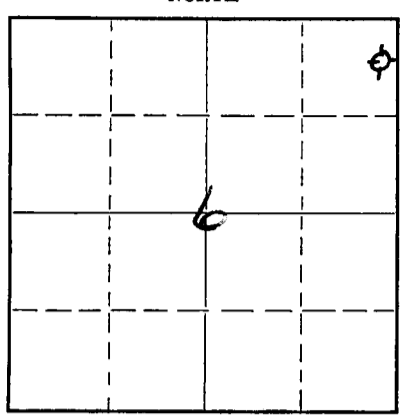

Locate well correctly on above Section Plat

Name of Conservation Agent who supervised plugging of this well A. L. Loman
Producing formation Burgess Sand Depth to top 2777 Bottom 2809 Total Depth of Well 2847' Feet
Show depth and thickness of all water, oil and gas formations.

OIL, GAS OR WATER RECORDS

CASING RECORD

Formation	Content	From	To	Size	Put In	Pulled Out

Describe in detail the manner in which the well was plugged, indicating where the mud fluid was placed and the method or methods used in introducing it into the hole. If cement or other plugs were used, state the character of same and depth placed, from feet to feet for each plug set.

5 sacks cement on bottom 2847' to 2800'
Mud to 165'
20 sacks cement on rock bridge to 145'
Mud to 15'
10' rock bridge with 5 sacks cement to surface

8-4-50

(If additional description is necessary, use BACK of this sheet)

Correspondence regarding this well should be addressed to John P. Gaty
Address 11 Cypress Drive
Wichita, Kansas

STATE OF Kansas, COUNTY OF Sedgwick, ss.
Max Howell (employee of owner) or (owner or operator) of the above-described well,

being first duly sworn on oath, says: That I have knowledge of the facts, statements, and matters herein contained and the log of the above-described well as filed and that the same are true and correct. So help me God.

(Signature) Max Howell
210 N. Edgemont (Address)

SUBSCRIBED AND SWORN to before me this 2d day of August 19 50
Edna G Hayes Notary Public.

My commission expires Feb 4, 1952

22-7377-g 4-49-10M
PLUGGING
FILE SEC 6 T 26 R 3 E
BOOK PAGE 13 LINE 23

DRILLING LOG

Company: John P. Gaty
 Farm: Villepigue No. 1
 Commenced: 5-14-50
 Completed: 6-28-50
 Contractor: Max Howell
 Casings: 1 1/2" at 95 ft.
 1 3/8" at 1035 ft.
 1 3/4" at 1495 ft.
 8-5/8" at 2407 ft.
 5 1/2" at 2801 ft.

E/2 NE NE Section 6-26S-3E
 Butler County, Kansas
 Cable Tools
 Total Depth 2847'

0-8	Hollar	867-872	Lime	1715-1740	Lime
-28	Clay	-882	Red Rock	-1745	Shale
-50	Shale	-900	Lime Shells	-1763	Lime
-55	Lime	-910	Lime	-1790	Lime
-65	Shale	-920	Shale	-1800	Shale
-75	Lime	-925	Lime	-1803	Lime
-125	Shale	-995	Shale	-1840	Shale
-135	Lime	-1000	Lime	-1850	Shale, Sandy
-140	Shale	-1008	Sandy Lime	-1890	Shale
-150	Lime	-1020	Sand	-1900	Lime
-165	Shale	-1029	Lime	-1940	Shale
-170	Red Rock	-1045	Shale	-1960	Lime
-180	Shale	-1047	Lime Shells	-1973	Shale
-225	Lime	-1085	Shale	-2000	Lime
-235	Shale	-1105	Lime	-2020	Shale
-280	Lime, Soft	-1108	Shale, Blk.	-2133	Lime
-325	Lime	-1113	Lime	-2135	Shale
-345	Shale	-1115	Shale, Blk.	-2188	Lime
-350	Red Rock	-1123	Shale	-2195	Shale
-365	Lime	-1135	Lime	-2233	Lime
-375	Shale	-1150	Shale & Shells	-2235	Shale
-380	Lime	-1160	Lime, Hard	-2245	Lime
-390	Shale	-1170	Shale	-2260	Shale
-395	Lime	-1185	Lime	-2265	Lime
-415	Shale	-1235	Shale	-2295	Shale & Shells
-435	Lime	-1245	Lime	-2320	Shale
-445	Red Rock	-1282	Shale	-2425	Lime
-475	Lime	-1288	Sand	-2447	Shale, Blk.
-490	Shale	-1292	Shale	-2470	Lime, Sandy
-512	Lime	-1330	Lime	-2474	Shale, Blk.
-517	Red Rock	-1335	Shale	-2490	Lime
-525	Shale	-1345	Lime	-2500	Lime, Broken
-530	Lime	-1360	Shale	-2563	Shale
-545	Shale	-1385	Lime	-2575	Lime
-555	Lime	-1398	Shale	-2605	Shale
-570	Shale	-1430	Lime	-2607	Lime
-580	Lime	-1434	Shale	-2610	Shale
-600	Shale	-1440	Lime	-2616	Lime
-615	Lime	-1447	Shale	-2635	Shale
-625	Shale	-1455	Lime, Sandy	-2645	Lime
-650	Lime	-1470	Shale	-2680	Shale & Shells
-660	Shale	-1487	Lime, White	-2696	Lime
-670	Lime	-1492	Broken Lime	-2720	Shale
-675	Shale, Blk.	-1530	Shale, Blue	-2740	Shale & Shells
-680	Lime, Brown	-1537	Lime	-2747	Lime
-685	Shale	-1548	Shale	-2754	Lime Shells
-720	Lime	-1560	Lime	-2760	V. C. Shale
-735	Shale and Shells	-1605	Shale	-2767	Lime
-750	Shale	-1635	Lime	-2773	Lime Shells
-780	Lime	-1640	Shale	-2777	Burgess Sand
-790	Lime Shells	-1650	Lime	-2809	Miss. Lime
-805	Shale	-1655	Shale, Blk.	-2815	Red Rock
-815	Lime	-1660	Lime	-2847	Lime
-830	Shale	-1665	Shale		
-848	Lime	-1695	Lime		
-855	Red Rock	-1700	Shale		
-860	Lime	-1710	Lime		
-867	Shale	-1715	Shale		

Water Record on Attached Sheet

PLUGGING
 FILE SEC 6 T 26 R 3E
 BOOK PAGE 13 LINE 23

Water Record for Villapigue No. 1 Well

65	to	75	Hole full
675	to	680	1 Bailer
830	to	840	3 Bailers
1003	to	1018	9 Bailers
1282	to	1288	3½ Bailers
1447	to	1455	7 Bailers
1750	to	1758	¾ Bailer
1980	to	1990	¾ Bailer
2085	to	2090	Hole Full
2500	to	2511	1½ Bailers