

15-163-30186-0000


STATE OF KANSAS
STATE CORPORATION COMMISSION

Form CP-4

Give All Information Completely
Make Required Affidavit
Mail or Deliver Report to:
Conservation Division
State Corporation Commission
211 No. Broadway
Wichita, Kansas

WELL PLUGGING RECORD

NORTH

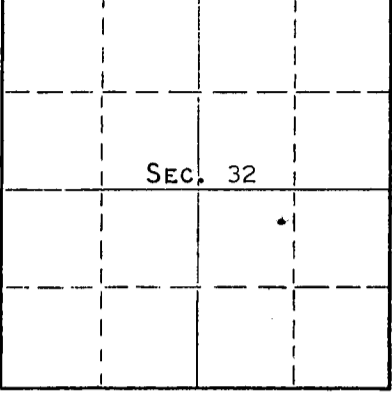

Locate well correctly on above
Section Plat

Rooks County, Sec. 32 Twp. 10s Rge. 20 (E) (W)
Location as "NE/CNW/SW" or footage from lines N/2 N/2 SE
Lease Owner PETROLEUM, INC.
Lease Name MCKENNA "D" Well No. 3
Office Address ROUTE #2, GREAT BEND, KANSAS
Character of Well (completed as Oil, Gas or Dry Hole) DRY HOLE
Date well completed FEB. 6 19 66
Application for plugging filed FEB. 6 19 66
Application for plugging approved FEB. 6 19 66
Plugging commenced FEB. 6 19 66
Plugging completed FEB. 6 19 66
Reason for abandonment of well or producing formation NO PRODUCIBLE ZONE

If a producing well is abandoned, date of last production NONE 19
Was permission obtained from the Conservation Division or its agents before plugging was commenced? YES

Name of Conservation Agent who supervised plugging of this well GILBERT LEIKER
Producing formation _____ Depth to top _____ Bottom _____ Total Depth of Well 3780' Feet
Show depth and thickness of all water, oil and gas formations.

OIL, GAS OR WATER RECORDS

CASING RECORD

| FORMATION | CONTENT | FROM | TO | SIZE | PUT IN | PULLED OUT |
|-----------|---------|------|----|-------|--------|------------|
| | | | | 8-5/8 | 212' | NONE |
| | | | | | | |
| | | | | | | |
Describe in detail the manner in which the well was plugged, indicating where the mud fluid was placed and the method or methods used in introducing it into the hole. If cement or other plugs were used, state the character of same and depth placed, from _____ feet to _____ feet for each plug set.

MUDDED UP WITH HEAVY MUD TO 540', FOLLOWED BY WOODEN PLUG, PLACED 20 SACKS CEMENT ON TOP OF PLUG. MUDDED UP WITH HEAVY MUD TO 200', FOLLOWED BY WOODEN PLUG, PLACED 20 SACKS CEMENT ON TOP OF PLUG. MUDDED UP WITH HEAVY MUD TO 40', FOLLOWED BY WOODEN PLUG, PLACED 1/2 SACK HULLS AND 10 SACKS CEMENT ON TOP OF PLUG TO BASE OF WELL CELLAR.

RECEIVED
FEB 10 1966
CONSERVATION DIVISION
WICHITA, KANSAS

(If additional description is necessary, use BACK of this sheet)
Name of Plugging Contractor GARVEY DRILLING COMPANY
Address R.R. #2, GREAT BEND, KANSAS

STATE OF KANSAS, COUNTY OF BARTON, ss.
MONTE CHADD (employee of owner) or (owner/operating) of the above-described

well, being first duly sworn on oath, says: That I have knowledge of the facts, statements, and matters herein contained and the log of the above-described well as filed and that the same are true and correct. So help me God. MONTE CHADD, DIST. PROD. SUPT.

(Signature) *Monte Chadd*

ROUTE #2, GREAT BEND, KANSAS
(Address)

SUBSCRIBED AND SWORN to before me this 9 day of FEBRUARY, 19 66

My commission expires MAY 28, 1969

Richard N. Dumble
Notary Public.

15-163-30186-0000

WELL LOG

COMPANY Petroleum Inc.

SEC. 32 T.10S R. 20W

FARM McKenna

NO. D-3

LOC. N $\frac{1}{2}$ -N $\frac{1}{2}$ -SE


TOTAL DEPTH 3780'

COUNTY Rooks

COMM. 1-28-66

COMP. 2-6-66

CONTRACTOR Garvey Drilling Company

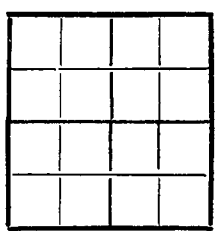

CASING 8 5/8" @ 212' w/175 sx

ELEVATION 2145' GL

PRODUCTION D & A

FIGURES INDICATE BOTTOM OF FORMATIONS

- 214' Shale
- 565' Shale and Shells
- 850' Sand
- 1000' Sand and Shale
- 1420' Shale and Red Bed
- 1620' Shale
- 1655' Anhydrite
- 2280' Shale and Shells
- 2375' Shale and Lime
- 3015' Lime and Shale
- 3120' Shale and Lime
- 3425' Lime and Shale
- 3740' Lime
- 3780' Dolomite
- 3780' RTD

RECEIVED
 STATE CORPORATION COMMISSION
 FEB 10 1966
 CONSERVATION DIVISION
 Topeka, Kansas

State of Kansas
 County of Barton } ss

I, Sam N. Stephens of Garvey Drilling Company

upon oath state the above and foregoing is a true and correct copy of the log of the McKenna D-3 well.

Sam N. Stephens

Subscribed and sworn to before me this 8th day of February 1966

My Commission Expires: November 5, 1969

Richard A. Boyd
 NOTARY PUBLIC

