


15-163-02223-0000

STATE OF KANSAS
STATE CORPORATION COMMISSION

Form CP-4

WELL PLUGGING RECORD

Give All Information Completely
Make Required Affidavit
Mail or Deliver Report to:
Conservation Division
State Corporation Commission
P. O. Box 17027
Wichita, Kansas 67217
NORTH

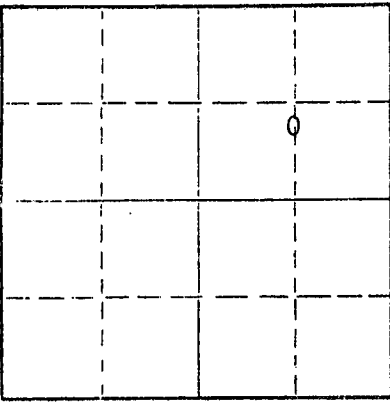

Locate well correctly on above
Section Plat

Rooks County, Sec. 32 Twp. 10S Rge. 20W (E) (W)
Location as "NE/CNW/SW" or footage from lines C N/2 S/2 NE/4
Lease Owner Brooks Hall Oil Corporation
Lease Name Wait Well No. 6
Office Address 1704 City National Bank Tower, Oklahoma City, Okla. 73102
Character of Well (completed as Oil, Gas or Dry Hole) Oil
Date well completed December 31 19 54
Application for plugging filed September 1 19 70
Application for plugging approved September 19 70
Plugging commenced September 19 70
Plugging completed September 20 19 70
Reason for abandonment of well or producing formation Ceased to produce

If a producing well is abandoned, date of last production July 19 70
Was permission obtained from the Conservation Division or its agents before plugging was commenced? Yes

Name of Conservation Agent who supervised plugging of this well
Producing formation Kansas City-Lansing Depth to top 3439 Bottom 3644 Total Depth of Well 3784 Feet
Show depth and thickness of all water, oil and gas formations.

OIL, GAS OR WATER RECORDS

CASING RECORD

FORMATION	CONTENT	FROM	TO	SIZE	PUT IN	PULLED OUT
Kansas City-Lansing	Oil	3439	3644	8-5/8	159	None
				5-1/2	3705	None

Describe in detail the manner in which the well was plugged, indicating where the mud fluid was placed and the method or methods used in introducing it into the hole. If cement or other plugs were used, state the character of same and depth placed, from _____ feet to _____ feet for each plug set.

Hole was filled w/mud laden material; 125 sx cement placed from 1384 to 50' of surface; filled w/mud laden material and cement placed at surface. Surface pipe was cut off & steel plate welded in place.

RECEIVED
STATE CORPORATION COMMISSION
AUG 30 1972
CONSERVATION DIVISION
Wichita, Kansas

(If additional description is necessary, use BACK of this sheet)
Name of Plugging Contractor Halliburton
Address P.O. Drawer 1431, Duncan, Oklahoma 73533

STATE OF Oklahoma, COUNTY OF Oklahoma, ss.
Bill Newport (employee of owner) of the above-described well, being first duly sworn on oath, says: That I have knowledge of the facts, statements, and matters herein contained and the log of the above-described well as filed and that the same are true and correct. So help me God.

(Signature) Bill Newport
1704 City Natl Bk Tower, Oklahoma City, Okla.
(Address)

SUBSCRIBED AND SWORN TO before me this 28th day of August, 19 72

My commission expires Dec. 8, 1974
Mary J Myers Notary Public.

15-163-02223-0000

DRILLERS' LOG

NAME:	#6 Wait	ELEVATION:	2172 GR 2175 DF 2178 KB
LOCATION:	C.N/2 S/2 NE/4 Sec. 32-10S-20W Rooks County, Kansas	DATE SPUDDED:	12-3-54
OPERATOR:	Heathman-Seeligson Drilling Co.	ROTARY COMPLETED:	12-14-54
CONTRACTOR:	Heathman-Seeligson Drilling Co.	ROTARY TOTAL DEPTH:	3784'
CASING RECORD:	8 jts. of 8-5/8 used 28# csg. set at 159' w/100 sacks cement, 1 Calcium Chloride. ,Cement Circulated.		
OIL STRING:	5 1/2" O.D. 8rd tnd. 14#, J-55 Smls. csg. cemented at 3705' w/ 100 sacks cement by Sun Cementing Co. Plug down 8:00 a.m. 12-14-54.		

GEOLOGICAL TOPS (KB)

Anhydrite	1628 (- 550)
Heebner	3412 (-1234)
Lansing	3449 (-1271)
Conglomerate	3712 (-1534)
R.T.D.	3784 (-1606)

LOG

(Figures indicate bottom of formation)

Surface Hole	0 - 159
Shale, Sand & Shells	1120
Sand	1360
Shale, Shells & Red Bed	1620
Shale & Red Bed	1628
Anhydrite	1670
Shale & Shells	2165
Lime & Shale	2340
Lime	2610
Lime & Shale	3470
Lime	3783
R.T.D.	3784'

RECEIVED
STATE CORPORATION COMMISSION
SEP 3 1970
CONSERVATION DIVISION
Wichita, Kansas

The undersigned, H. D. Shreve, of Heathman-Seeligson Drilling Co., hereby certifies that the above log is a true and correct log of the formations encountered in drilling the above well as reflected by the Daily Drilling Reports.

HEATHMAN-SEELIGSON DRILLING CO.

By: 

Subscribed and sworn to before
me this 20th day of December, 1954.

E. Marjorie Matt
Notary Public

My Commission Expires: June 28, 1956.