


Give All Information Completely  
Make Required Affidavit  
Mail or Deliver Report to:  
Conservation Division  
State Corporation Commission  
800 Bittig Building  
Wichita, Kansas

WELL PLUGGING RECORD

Rooks County, Sec. 32 Twp. 10S Rge. 20 (E) W (W)

Location as "NE/CNW%SW%" or footage from lines G NE NE NW  
Lease Owner The Derby Oil Company  
Lease Name Schneider Well No. 1  
Office Address P. O. Box 1030, Wichita, Kansas  
Character of Well (completed as Oil, Gas or Dry Hole) Dry Hole  
Date well completed April 5, 1954  
Application for plugging filed April 5, 1954  
Application for plugging approved April 5, 1954  
Plugging commenced April 5, 1954  
Plugging completed April 5, 1954  
Reason for abandonment of well or producing formation Drv hole

NORTH

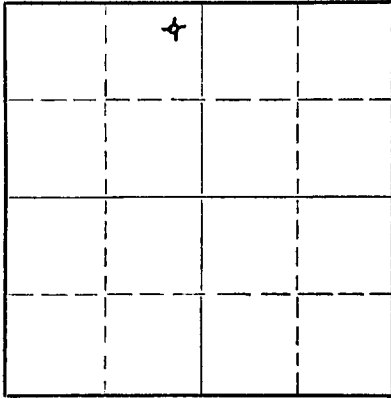

Locate well correctly on above  
Section Plat

If a producing well is abandoned, date of last production \_\_\_\_\_ 19\_\_\_\_  
Was permission obtained from the Conservation Division or its agents before plugging was commenced? Yes

Name of Conservation Agent who supervised plugging of this well Eldon Petty  
Producing formation \_\_\_\_\_ Depth to top \_\_\_\_\_ Bottom \_\_\_\_\_ Total Depth of Well 3770 Feet  
Show depth and thickness of all water, oil and gas formations.

OIL, GAS OR WATER RECORDS

CASING RECORD

FORMATION	CONTENT	FROM	TO	SIZE	PUT IN	PULLED OUT
		0	219	8 5/8	219	None

Describe in detail the manner in which the well was plugged, indicating where the mud fluid was placed and the method or methods used in introducing it into the hole. If cement or other plugs were used, state the character of same and depth placed, from \_\_\_\_\_ feet to \_\_\_\_\_ feet for each plug set.

3770 to 211 1/2 - heavy rotary mud  
211 1/2 to 210 - wooden plug  
210 to 164 - 15 sacks cement and 1/2 sack hulls  
164 to 41 1/2 - heavy rotary mud  
41 1/2 to 40 - wooden plug  
40 to 6 - 10 sacks cement and 1/2 sack hulls  
6 to surface - cellar

04-15-54

(If additional description is necessary, use BACK of this sheet)

Name of Plugging Contractor Glenn W. Peel  
Address P.O. Box 350, Hoisington, Kansas

STATE OF KANSAS, COUNTY OF BARTON, ss.  
Glenn W. Peel (employee of owner) or (owner or operator) of the above-described well, being first duly sworn on oath, says: That I have knowledge of the facts, statements, and matters herein contained and the log of the above-described well as filed and that the same are true and correct. So help me God. GLENN W. PEEL

(Signature) [Signature] BY: [Signature]  
P.O. Box 359, Hoisington, Kansas  
(Address)

SUBSCRIBED AND SWORN TO before me this 7th day of April, 19 54

[Signature]  
Notary Public.

My commission expires June 4, 1955

PLUGGING  
FILE NO. 32-10-2010  
BOOK PAGE 25 LINE 33

DRILLERS' LOG

Company: The Derby Oil Company  
Farm Name: Schneider Well No. 1  
Total Depth: 3770'  
Comm: 3-25-54 Comp: 4-3-54  
Contractor: Glenn W. Peel  
Casing: 8 5/8" 219' cem.

C NE NE NW  
Sec. 32, Twp. 10S, Rge. 20W,  
County: Rooks,  
Kansas  
Elevation:  
Productions: Dry

Figures below indicate bottoms of formations:

Sand shale and shells	0 -	221
Shale		680
Sand and shale		760
Shale		1100
Shale and sand		1620
Anhydrite		1665
Shale		1740
Shale and shells		2155
Shale and lime		2465
Lime		2620
Shale and lime		3225
Lime		3680
Conglomerate		3730
Shale and lime		3750
Lime		3770
Total depth		3770

This is to certify that the above information is to the best of our knowledge, true and correct.

GLENN W. PEEL

BY: Glenn W. Peel

SUBSCRIBED AND SWORN to before me this 7<sup>th</sup> day of April, 1954.

My commission expires: June 4, 1955

Marion M. Herbst  
Notary Public

RECEIVED  
APR 15 1954  
CONSERVATION DIVISION  
Wichita, Kansas

**PLUGGING**  
FILE SEC 32 T 10 R 20W  
BOOK PAGE 25 LINE 33