

15-163-00952-0000


STATE OF KANSAS
STATE CORPORATION COMMISSION

WELL PLUGGING RECORD

Give All Information Completely
Make Required Affidavit
Mail or Deliver Report to:
Conservation Division
State Corporation Commission
800 Bittling Building
Wichita, Kansas

Rooks County. Sec. 36 Twp. 10 Rge. 20 (E) (W)
Location as "NE/CNW 1/4 SW 1/4" or footage from lines NE-SW-NW
Lease Owner Herman George Kaiser, Oil Producer
Lease Name Trarbach Well No. 1
Office Address 908 Palace Bldg. Tulsa, Okla.
Character of Well (completed as Oil, Gas or Dry Hole) oil
Date well completed March 8 19 56
Application for plugging filed January 3 19 66
Application for plugging approved January 4 19 66
Plugging commenced January 11 19 66
Plugging completed January 11 19 66
Reason for abandonment of well or producing formation uneconomical

NORTH

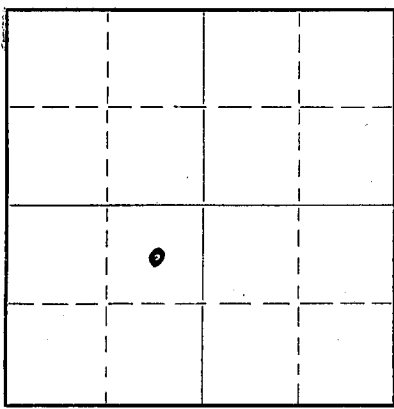

Locate well correctly on above
Section Plat.

If a producing well is abandoned, date of last production December 31 19 65
Was permission obtained from the Conservation Division or its agents before plugging was commenced? yes

Name of Conservation Agent who supervised plugging of this well Mr. Gilbert Leiker
Producing formation Arbuckle Depth to top 3679' Bottom 3688' Total Depth of Well 3688' Feet
Show depth and thickness of all water, oil and gas formations.

OIL, GAS OR WATER RECORDS

CASING RECORD

Formation	Content	From	To	Size	Put In	Pulled Out
				8-5/8"	192'	none
				5-1/2"	3681'	none

Describe in detail the manner in which the well was plugged, indicating where the mud fluid was placed and the method or methods used in introducing it into the hole. If cement or other plugs were used, state the character of same and depth placed, from _____ feet to _____ feet for each plug set.

Pressure up between 5 1/2" and 8" casing at 500#. Pressure held.
Mix 32 sacks of mud, pump in @ 300#. Mud plug from 600' to 3688'.
Mix 75 sacks of cement, pump in @ 500#. Cement plug from 0' to 600'

RECEIVED
STATE CORPORATION COMMISSION

MAY 3 - 1966

CONSERVATION DIVISION
WICHITA, KANSAS

(If additional description is necessary, use BACK of this sheet)

Correspondence regarding this well should be addressed to Herman George Kaiser, Oil Producer
Address Box 791 Hays, Kansas

STATE OF Kansas, COUNTY OF Ellis, ss.

I, Robert R. Scott (employee of owner) or (owner or operator) of the above-described well, being first duly sworn on oath, says: That I have knowledge of the facts, statements, and matters herein contained and the log of the above-described well as filed and that the same are true and correct. So help me God.

(Signature) Robert R. Scott

Box 791 Hays, Kansas (Address)

SUBSCRIBED AND SWORN TO before me this 2nd day of May, 1966, 19__

My commission expires 3-30-68

Notary Public

Herman George Kaiser - Francis Oil & Gas, Inc.
Trarbach #1.

NE SW NW Sec. 36-10-20W
Rooks County, Kansas

Comm: 2-20-56
Comp: 2-29-56

Total Depth 3685

<u>Casing</u>	<u>Cement</u>
8 5/8" @ 192'	150 sacks
5 1/2" @ 3681'	125 sacks

<u>FORMATION</u>	<u>DEPTH</u>
Rock	0 - 50
Clay & shale	50 - 150
Shale	150 - 192
Shale	192 - 540
Sand & shale	540 - 630
Shale - sand	630 - 1045
Sand	1045 - 1255
Shale	1255 - 1515
Shale	1515 - 1530
Anhydrite	1530 - 1575
Shale & shells	1575 - 1835
Shale lime	2115 - 2310
Shale & Lime	2310 - 3200
Lime	3200 - 3272
Lime & shale	3272 - 3325
Lime	3325 - 3619
Lime - shale - cherty	3619 - 3650
Lime & shale	3650 - 3685

RECEIVED
STATE CORPORATION COMMISSION

JAN 4 1966

CONSERVATION DISTRICT
Wichita, Kansas

STATE OF KANSAS)
) SS
SEDGWICK COUNTY)

I hereby certify that the above information is true and correct to the best of my knowledge.

[Signature]

Subscribed and sworn to before me this 6th day of March, 1956.

My commission expires: June 25, 1956

[Signature]
Frances Marier