

KANSAS CORPORATION COMMISSION  
OIL & GAS CONSERVATION DIVISION  
**WELL PLUGGING APPLICATION**  
Please TYPE Form and File ONE Copy

Form CP-1  
March 2009  
This Form must be Typed  
Form must be Signed  
All blanks must be Filled

OPERATOR: License #: 31790  
Name: FREMONT EXPLORATION, INC.  
Address 1: 12412 St. Andrews Drive  
Address 2: \_\_\_\_\_  
City: Oklahoma City State: OK Zip: 73120 + \_\_\_\_\_  
Contact Person: Tom Conroy  
Phone: ( 405 ) 936-0012

API No. 15 - 119-20910 -0000  
If pre 1967, supply original completion date: \_\_\_\_\_  
Spot Description: \_\_\_\_\_  
NW SE SE Sec. 16 Twp. 32 S. R. 26  East  West  
1,100 Feet from  North /  South Line of Section  
1,300 Feet from  East /  West Line of Section  
Footages Calculated from Nearest Outside Section Corner:  
 NE  NW  SE  SW  
County: MEADE  
Lease Name: LAUPPE Well #: 16-1

Check One:  Oil Well  Gas Well  OG  D&A  Cathodic  Water Supply Well  Other: \_\_\_\_\_  
 SWD Permit #: \_\_\_\_\_  ENHR Permit #: \_\_\_\_\_  Gas Storage Permit #: \_\_\_\_\_  
Conductor Casing Size: \_\_\_\_\_ Set at: \_\_\_\_\_ Cemented with: \_\_\_\_\_ Sacks  
Surface Casing Size: 8 5/8 Set at: 995 Cemented with: 410 Sacks  
Production Casing Size: 2 7/8 Set at: 5650 Cemented with: 200 Sacks

List (ALL) Perforations and Bridge Plug Sets:

Perfs 5470 - 5486

Elevation: 2395 ( G.L. /  K.B.) T.D.: 5650 PBTD: 5542 Anhydrite Depth: 1950'  
(Stone Corral Formation)

Condition of Well:  Good  Poor  Junk in Hole  Casing Leak at: 3100'  
(Interval)

Proposed Method of Plugging (attach a separate page if additional space is needed):

Pump 25 sacks cement plug down 2 7/8" casing. Cut 2 7/8" casing at 2800' & pull casing to 1050'. Spot 30 sacks cement plug down 2 7/8" at base of surface casing (995'). Spot 10 sacks plug at surface. Cut off 8 5/8" below ground and backfill. See attached schematic

Is Well Log attached to this application?  Yes  No Is ACO-1 filed?  Yes  No

If ACO-1 not filed, explain why:

RECEIVED  
NOV 02 2009

Plugging of this Well will be done in accordance with K.S.A. 55-101 et. seq. and the Rules and Regulations of the State Corporation Commission

Company Representative authorized to supervise plugging operations: Tim Ross  
Address: P.O. Box 774 City: Meade State: KS Zip: 67864 + \_\_\_\_\_  
Phone: ( 620 ) 629-1403  
Plugging Contractor License #: 31151 Name: Sargent & Horton Well Plugging  
Address 1: RR #1, Box 49 BA Address 2: \_\_\_\_\_  
City: Tyrone State: OK Zip: 73951 + \_\_\_\_\_  
Phone: ( 580 ) 854-6515  
Proposed Date of Plugging (if known): \_\_\_\_\_

Payment of the Plugging Fee (K.A.R. 82-3-118) will be guaranteed by Operator or Agent

Date: 10-29-09 Authorized Operator / Agent: Tom Conroy (Signature)


Dist 1  
PET

Fremont Exploration, INC.

# LAUPPE #16-1

Date: 10/27/2009

Sec. 16-32S-26W  
Meade County, Kansas

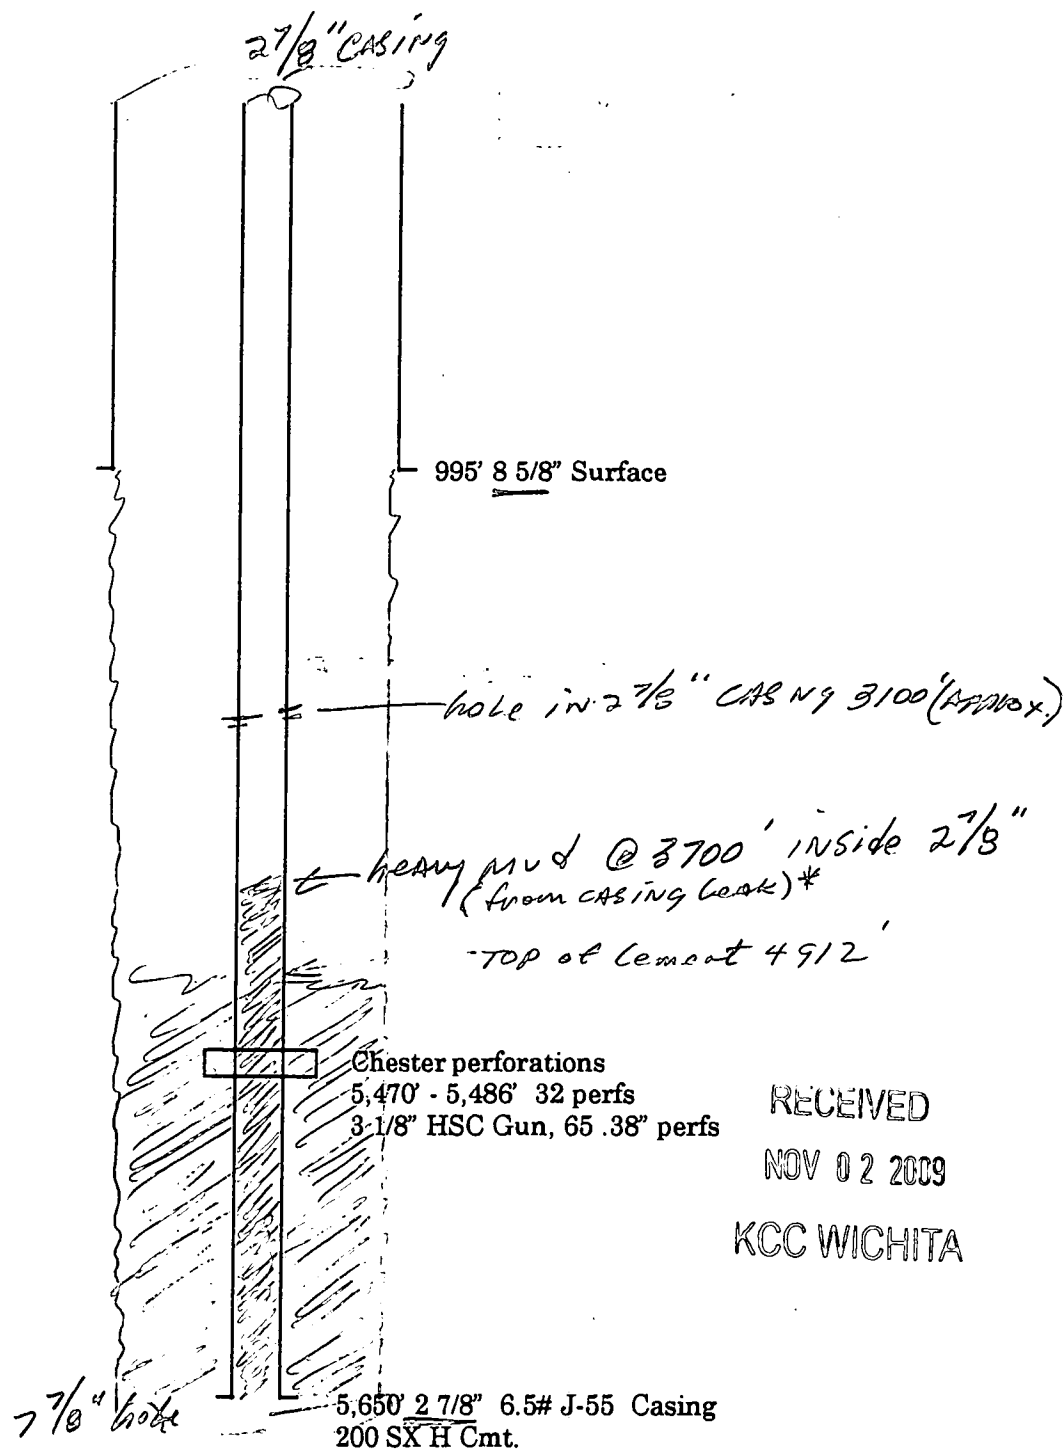

RECEIVED

NOV 02 2009

KCC WICHITA

\* Unable to get past 3700' with snabs due to heavy mud inside 2 7/8" casing



CORPORATION COMMISSION

Mark Parkinson, Governor Thomas E. Wright, Chairman Michael C. Moffet, Commissioner Joseph F. Harkins, Commissioner

**NOTICE OF RECEIPT OF WELL PLUGGING APPLICATION (CP-1)**

FREMONT EXPLORATION, INC.  
12412 SAINT ANDREWS DR  
OKLAHOMA CITY, OK 73120-8601

November 05, 2009

Re: LAUPPE #16-1  
API 15-119-20910-00-00  
16-32S-26W, 1100 FSL 1300 FEL  
MEADE COUNTY, KANSAS

Dear Operator:

This letter is to notify you that the Conservation Division has received your plugging proposal, form CP-1, for the above well and has reviewed the proposal for completeness. The central office will now forward your CP-1 to the district office listed below for review of the proposed plugging method. **Please contact the district office for approval of your proposed plugging method at least five (5) days before plugging the well, pursuant to K.A.R. 82-3-113(b). If a workover pit will be used during the plugging of the well it must be permitted. A CDP-1 form must be filed and approved prior to the use of the pit in accordance with K.A.R. 82-3-600.**

The Conservation Division's review of form CP-1, either in the central or district office, does not include an inquiry into well ownership or the filing operator's legal right to plug the well. This notice in no way constitutes authorization to plug the above well by persons not having legal rights of ownership or interest in the well.

**This notice is void after May 4, 2010. The CP-1 filing does not bring the above well into compliance with K.A.R. 82-3-111 with regard to the Commission's temporary abandonment requirements.**

Sincerely,

Steve Bond  
Production Department Supervisor

District: #1  
210 E Frontview, Suite A  
Dodge City, KS 67801  
(620) 225-8888