


STATE OF KANSAS
STATE CORPORATION COMMISSION

15-051-22116-00-00
WELL PLUGGING RECORD

Give All Information Completely
Make Required Affidavit
Mail or Deliver Report to
Conservation Division
State Corporation Comm.
245 North Water
Wichita, KS 67202

Ellis County. Sec. 35 Twp. 12S Rge. 19 E/W
Location as "NE/CNW $\frac{1}{4}$ /SW $\frac{1}{4}$ " or footage from lines
N/2 NW/4 NW/4

Lease Owner Jay C. Boyer
Lease Name Hite Well No. #1
Office Address 2900 Walnut, Hays, Kansas 67601
Character of Well (Completed as Oil, Gas or Dry Hole)
Dry Hole

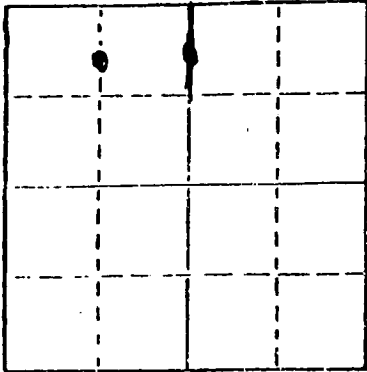

Date Well completed 10-25 1980
Application for plugging filed 10-25 1980
Application for plugging approved 10-25 1980
Plugging commenced 10-25 1980
Plugging completed 10-25 1980

Reason for abandonment of well or producing formation
Dry Hole

If a producing well is abandoned, date of last production
19.

Was permission obtained from the Conservation Division or
its agents before plugging was commenced? Yes

Name of Conservation Agent who supervised plugging of this well Marion Schmidt
Producing formation Depth to top Bottom Total Depth of Well 3670'
Show depth and thickness of all water, oil and gas formations.

OIL, GAS OR WATER RECORDS

CASING RECORD

FORMATION	CONTENT	FROM	TO	SIZE	PUT IN	PULLED OUT
				8 5/8"	208'	-0-

Describe in detail the manner in which the well was plugged, indicating where the mud fluid was placed and the method or methods used in introducing it into the hold. If cement or other plugs were used, state the character of same and depth placed, from feet to feet for each plug set.

Mud laden fluid 3670 to 980'
70 sx cement @ 980'
25 sx cement @ 180'
10 sx cement @ 40'

RECEIVED
STATE CORPORATION COMMISSION
11-10-1980
NOV 10 1980

(If additional description is necessary, use BACK of this sheet)

Name of Plugging Contractor Ranger Drilling Company, Inc. Conservation Division
Box 717, Hays, Kansas 67601 Wichita, Kansas

STATE OF KANSAS COUNTY OF ELLIS, ss.
William A. Spivey (employee of owner) or (owner or operator)
of the above-described well, being first duly sworn on oath, says: That I have knowledge of the facts, statements, and matters herein contained and the log of the above-described well as filed and that the same are true and correct. So help me God.

(Signature) William A. Spivey
Box 717, Hays, Kansas 67601 (Address)

MARIETTA KOHLRUS
NOTARY PUBLIC
STATE OF KANSAS
ELLIS COUNTY, KANSAS
MY APPT. EXP. 2-23-84

29th day of October, 1980
Marietta Kohlrus
Notary Public.

My commission expires February 23, 1984

